

MISSISSIPPI DEPARTMENT OF NATURAL RESOURCES

Bureau of Land and Water Resources

Southport Mall

P.O. Box 10631

Jackson, Mississippi 39209

WATER WELL DRILLERS LOG

CODED

Hancock
A40

3-5-84 date well completed 19 firm name POUNCEY WATER WELL DRILLING Hancock county well located

LANDOWNER: Joe Riders
Acacia Crossing
Perkinator Pl.
(mailing address)

WELL LOCATION:
sec 18 T 5 N R 15 E
1 1/2 miles (distance) (direction) of (nearest town)
Acacia Crossing

WELL PURPOSE: Home
(home, irrigation, municipal, industrial)

- WELL COMPLETION DATA:
- (1) diameter (inches) 2
 - (2) total depth (feet) 670
 - (3) static water level (feet) 8.5 below top of ground
 - (4) casing PVC 650 (material), (depth)
2 (size) - If telescope see back.
 - (5) screen 20 650 (length), (depth to top)
2 (size), PVC (material)
 - (6) pump 1 (HP) 8 (yield gpm)
220V AC (type power)
 - (7) electric log (yes or no)
 - (organization running log)
 - (8) how well bottom plugged Sealed

description of formations encountered	from	to
Clay	0	230
slt.	230	276
Clay	276	360
slt.	360	430
Clay	430	508
slt & slt streaks	508	604
int clay		
slt & slt	604	670

CODED

DEPT. OF NATURAL RESOURCES
BUREAU OF LAND & WATER RESOURCES


SEP 10 1984

RECEIVED

DRILLERS REMARKS: Well in slt due to

If well telescopes please sketch and show depths.

GROUND LEVEL

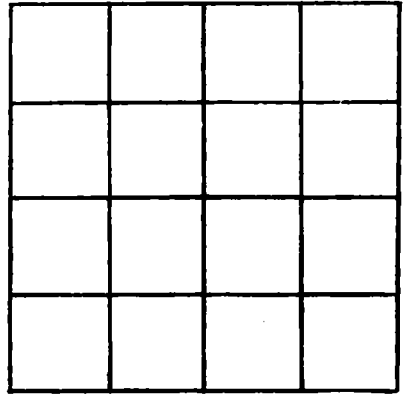

SECTION _____

Please indicate well location X.

ADDITIONAL INFORMATION

If more than one screen, show locations of each on sketch.