

MISSISSIPPI DEPARTMENT OF NATURAL RESOURCES

Bureau of Land and Water Resources **CODED**

Southport Mall

P.O. Box 10631

Jackson, Mississippi 39209

WATER WELL DRILLERS LOG

POUNCEY WATER WELL DRILLING *Hancock*

Hancock
A 42
3/27/85

date well completed

firm name

county well located

LANDOWNER:

Benny Waldrop
Rd. 3

description of formations encountered

from

to

Pouncey, ms.
(mailing address)

Top 0 *12*
SD Big 12 *26*
SD Pink junky 26 *66*
Good Brown SD. 66 *80*

WELL LOCATION:

sec *33* T *5* N R *15* E
(S) (W)
10 miles *E* of *Pouncey*
(distance) (direction) (nearest town)

WELL PURPOSE:

(home, irrigation, municipal, industrial)

Home

CODED

WELL COMPLETION DATA:

- (1) diameter (inches) *2*
- (2) total depth (feet) *80*
- (3) static water level (feet) *38* below top of ground above
- (4) casing *PVC 70*
(material) (depth)
- 2*
(size) If telescope see back.
- (5) screen *10 70*
(length) (depth to top)
- 2 PVC*
(size) (material)
- (6) pump *1 10*
(HP) (yield gpm)
- 230 V AC*
(type power)
- (7) electric log (yes or no)

(organization running log)

(8) how well bottom plugged *Sealed*

DRILLERS REMARKS:


RECEIVED

MAY 28 1985

Department of Natural Resources
Bureau of Land & Water Resources

If well telescopes please sketch and show depths.

GROUND LEVEL

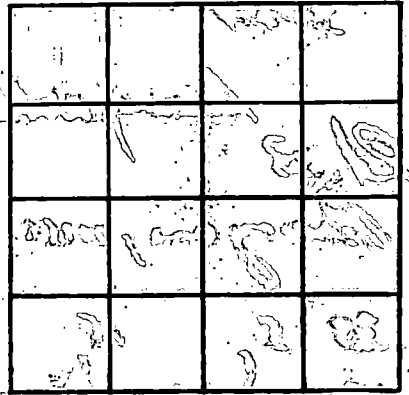

SECTION _____

Please indicate well location X.

ADDITIONAL INFORMATION

If more than one screen, show locations of each on sketch.