

WATER WELL DRILLERS LOG

Date: 9-12, 1966, Driller: Walter Penlon County Hancock
 (Name)

(1) Owner of Land: H. Pearson
 (Name)
Rt. 2 Carriere Miss
 (Address)

(2) Location: NW 1/4, SW 1/4, Sec. 18 T55R15W
11 miles N.E. of Picayune
 (distance) (direction) (Nearest Town)

(3) Topography: Hilly
 (Hilly) (Flat) (Level)

(4) Purpose of Well: Domestic
 (Domestic Irrigation
 Municipal, Industrial, Other)

Description & Color of Materials Sand, Clay, Red Clay, Shell, etc.	Thick- ness Feet	Depth Feet
Clay	26	0-2
Red Sand	32	58
Sand	41	99
Blue Clay	92	191
Grey Sand	27	218


Information upon completion of well:

- (1) Diameter 2 inches.
- (2) Total Depth 218 feet.
- (3) Water Level 87 feet below top of ground.
- (4) Cased to 213, Size 2"
- (5) Screen: Size 2" .012, Length 5'
- (6) Were any formations sealed against pollution?
 _____ yes, _____ no.

If YES depth of formation _____

Why _____

Drillers Remarks: _____

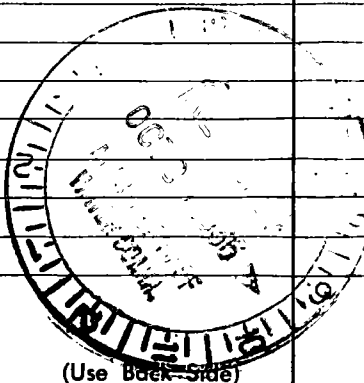

(Use Back Side)

Well No.

