

Hancock
A 2008
9-66

MISSISSIPPI BOARD OF WATER COMMISSIONERS

WATER WELL DRILLERS LOG

Hancock

Date: 9-12, 1966, Driller: Walter Penlon County Hancock

(Name)

(1) Owner of Land: Mr Pearson
(Name)

Rt 1 Poyune Miss
(Address)

(2) Location: NW 1/4, SW 1/4, Sec 18 T5R15

11 miles N.E. of Poyune
(distance) (direction) (Nearest town)

(3) Topography: Hilly
(Hilly) (Flat) (Level)

(4) Purpose of Well: Domestic
(Domestic Irrigation
Municipal, Industrial, Other)

Description & Color of Materials
Sand, Clay, Red Clay, Shell, etc.

Thick-
ness
Feet

Depth
Feet

Clay	260-26
Red Sand	2258
Sand	4199
Blue Clay	92191
Grey Sand	27218

Information upon completion of well:

(1) Diameter 2 inches.

(2) Total Depth 218 feet.

(3) Water Level 67 feet below top of ground.

(4) Cased to 213', Size 2"

(5) Screen: Size 012, Length 5'


(6) Were any formations sealed against pollution?
yes, no.

If YES depth of formation _____

Why _____

Drillers Remarks: _____

Pump NP-1
6PM-6
Tap Power-Elke

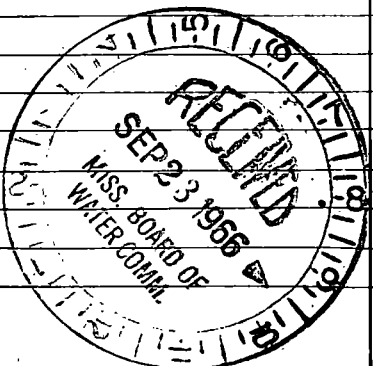

(Use Back Side)

Well No.

