

Hancock
A 2004
4-67

MISSISSIPPI
BOARD OF WATER COMMISSIONERS
416 North State Street
Jackson, Mississippi 39201

WATER WELL DRILLERS LOG

4 - 19 1967 Panton Well Serv Hancock
date well completed firm name county well located

LANDOWNER: Edward E Pearson

description of formations encountered

from to

Rb 2 NO Box #

Red Clay

0 19

Carriere Miss
(mailing address)

sand

19 82

Blue clay

82 180

Grey sand

180 216

WELL LOCATION:

sec. 18 T 5 S R 15 W
2 miles North of Cesar
(distance) (direction) (nearest town)

WELL PURPOSE: Home
(home, irrigation, municipal, industrial)

WELL COMPLETION DATA:

(1) diameter (inches) 2
(2) total depth (feet) 216
(3) static water level (feet) 86 below top of ground.

(4) casing Galv. steel, 211,
(material) (depth)
 If telescope see back.
(size)


(5) screen 5', 211,
(length) (depth to top)
2", S. steel
(size) (material)

(6) pump 1, 300 h
(HP) (yield gpm)
Elec
(type power)

(7) electric log NO
(yes or no)
(organization running log)

(8) how well bottom plugged Bw Value

DRILLERS REMARKS:

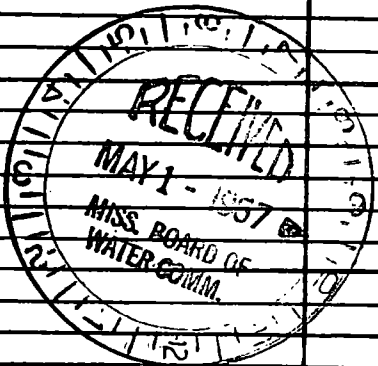

If well telescopes please sketch and show depths.

GROUND LEVEL

X			

SECTION 18

Please indicate well location X.

ADDITIONAL INFORMATION

If more than one screen, show locations of each on sketch.