

Hancock
 A 2005
 4-67

MISSISSIPPI
 BOARD OF WATER COMMISSIONERS
 416 North State Street
 Jackson, Mississippi 39201

WATER WELL DRILLERS LOG

4-30 1967 Ponton Well Serv Hancock
 date well completed firm name county well located

LANDOWNER: Z. T. Jones
 Rt. 2 Box 240
 Carriere Miss
 (mailing address)

description of formations encountered	from	to
	Red Clay	0
" Sand	28	132
Blue Clay	132	185
Grey Sand	185	217


WELL LOCATION:
 sec. 18 T. 5 S. R. 15 W.
 2 miles North of Cozzar
 (distance) (direction) (nearest town)

WELL PURPOSE: Home
 (home, irrigation, municipal, industrial)

WELL COMPLETION DATA:

- (1) diameter (inches) 2
- (2) total depth (feet) 217
- (3) static water level (feet) 87 below top of ground
- (4) casing Galv Steel 2 1/2 (material) (depth)
 if telescope see back.
 (size)
- (5) screen 5' 2 1/2 (length) (depth to top)
 1012 2" S. Steel (size) (material)
- (6) pump 1 310 h (HP) (yield gpm)
 Elec (type power)
- (7) electric log No (yes or no)
 (organization running log)
- (8) how well bottom plugged BW Valve

DRILLERS REMARKS:

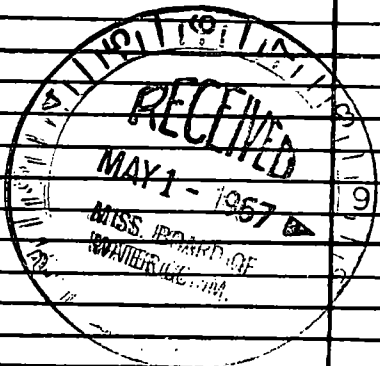

If well telescopes please sketch and show depths.

GROUND LEVEL

X			

SECTION 78

Please indicate well location X.

ADDITIONAL INFORMATION

If more than one screen, show locations of each on sketch.