

**MISSISSIPPI
BOARD OF WATER COMMISSIONERS**
416 North State Street
Jackson, Mississippi 39201

WATER WELL DRILLERS LOG

Hancock
A 2006
5-67

5-1 1967 Penton Well Soru Hancock
date well completed firm name county well located

LANDOWNER: Earnest Greater
Ph 2 NO BOX
Carriere Miss
(mailing address)


description of formations encountered	from	to
<u>Red Clay</u>	<u>0</u>	<u>24</u>
<u>" Sand & Mud</u>	<u>24</u>	<u>98</u>
<u>Blue Clay</u>	<u>98</u>	<u>176</u>
<u>Grey Sand</u>	<u>176</u>	<u>202</u>

WELL LOCATION:
sec. 18 T. 5 S. R. 15 W.
2 miles N. of Ceasar
(distance) (direction) (nearest town)

WELL PURPOSE: Home
(home, irrigation, municipal, industrial)

- WELL COMPLETION DATA:
- (1) diameter (inches) 2"
 - (2) total depth (feet) 202
 - (3) static water level (feet) 86 below above top of ground.
 - (4) casing Galv. steel 197,
(material) (depth)
2" ✓ if telescope see back.
(size)
 - (5) screen 5', 197
(length) (depth to top)
2", S. steel
(size) (material)
 - (6) pump 1, 315 h
(HP) (yield gpm)
Elec
(type power)
 - (7) electric log NO
(yes or no)
✓
(organization running log)
 - (8) how well bottom plugged BW. Valve

DRILLERS REMARKS:

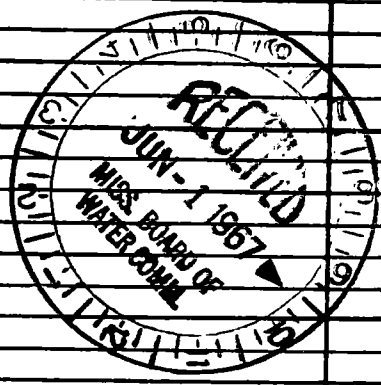

If well telescopes please sketch and show depths.

GROUND LEVEL

SECTION 18

Please indicate well location X.

ADDITIONAL INFORMATION

If more than one screen, show locations of each on sketch.