

HANCOCK
A 2007
6-67

MISSISSIPPI
BOARD OF WATER COMMISSIONERS
416 North State Street
Jackson, Mississippi 39201

WATER WELL DRILLERS LOG

6-26 1967 Penon Well Serv HANCOCK
date well completed firm name county well located

LANDOWNER: Durwin Spence
NO BOX

Rt. 2

Carriere Miss
(mailing address)

WELL LOCATION:

sec. 19 T. 5 N R. 15 W
S W
2 miles N of Cezar
(distance) (direction) (nearest town)

WELL PURPOSE: Home
(home, irrigation, municipal, industrial)


WELL COMPLETION DATA:

- (1) diameter (inches) 2"
- (2) total depth (feet) 185
- (3) static water level (feet) 62 below top of ground.
- (4) casing Galv 180
(material) (depth)
2 if telescope see back.
(size)
- (5) screen 5' 180'
(length) (depth to top)
.012 2" S. Steel
(size) (material)
- (6) pump 1 8
(HP) (yield gpm)
Elec
(type power)
- (7) electric log No
(yes or no)
(organization running log)
- (8) how well bottom plugged Bw Valve

description of formations encountered

from to

Red clay	0	25
" sand	25	52
Blue clay	53	118
" sand	118	124
Blue clay	124	154
Grey sand	154	185

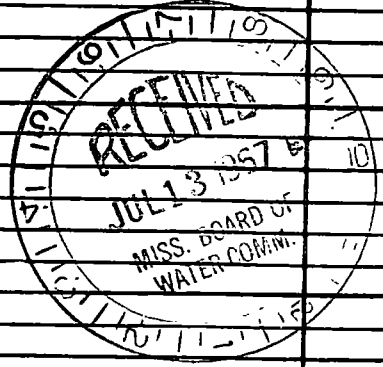

DRILLERS REMARKS:

If well telescopes please sketch and show depths.

GROUND LEVEL

x			

SECTION 19

Please indicate well location X.

ADDITIONAL INFORMATION

If more than one screen, show locations of each on sketch.