

HANCOCK  
A 2008  
10-67

MISSISSIPPI  
 BOARD OF WATER COMMISSIONERS  
 416 North State Street  
 Jackson, Mississippi 39201

WATER WELL DRILLERS LOG

10-6 1967 Penlon Well Serv HANCOCK  
 date well completed firm name county well located

LANDOWNER: Curtis Lee

Rh 2 Box 160

Carriere Miss  
 (mailing address)

WELL LOCATION:

sec. 19 T. 5 S. R. 16 E. W.  
2 miles North of Caesar  
 (distance) (direction) (nearest town)

WELL PURPOSE: Home  
 (home, irrigation, municipal, industrial)


WELL COMPLETION DATA:

- (1) diameter (inches) 4 1/2" Drilled
- (2) total depth (feet) 216
- (3) static water level (feet) 53 below  
 top of ground.
- (4) casing Galv. steel 210'  
 (material) (depth)  
2"  
 (size) if telescope see back.
- (5) screen 5', 210'  
 (length) (depth to top)  
.012-2", S. Steel  
 (size) (material)
- (6) pump 1 9  
 (HP) (yield gpm)  
Elec  
 (type power)
- (7) electric log No  
 (yes or no)

(organization running log)

(8) how well bottom plugged B.W. Valve

description of formations encountered	from	to
Red Clay	0	28
" SAND	28	44
White Clay	44	52
Blue Clay	52	178
Grey Sand	178	216

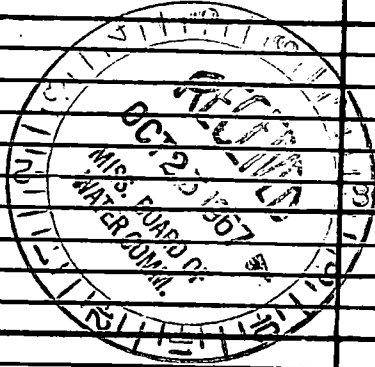

DRILLERS REMARKS:

