

**HANCOCK**  
**A. 2014**  
**12-28-77**

**MISSISSIPPI**  
**BOARD OF WATER COMMISSIONERS**  
 416 North State Street  
 135 Jackson, Mississippi 39201

**WATER WELL DRILLERS LOG**

*Hancock Co.*  
*1977 Bud Denton & Son*  
*Prad River*

**12-28**  
 date well completed

**1977 Bud Denton & Son**  
 firm name

**Hancock Co.**  
 county well located

**LANDOWNER:**

*James C. Lee*  
*Pecayun, Miss*  
 (mailing address)

**description of formations encountered**

*Red Shale*  
*White sand*  
*Blue Shale*  
*Gray sand*

from	to
0	70
70	105
105	202
202	218

**WELL LOCATION:**

sec. 9 T. 5 N. R. 15 E  
 S  
6 miles E of Pecayun  
 (distance) (direction) (nearest town)

**WELL PURPOSE:**

*Home*  
 (home, irrigation, municipal, industrial)

**WELL COMPLETION DATA:**

- (1) diameter (inches) 2 in
- (2) total depth (feet) 218
- (3) static water level (feet) 32 below top of ground.
- (4) casing PVC 208  
 (material) (depth)

\_\_\_\_\_ If telescope see back.  
 (size)

- (5) screen 10 208  
 (length) (depth to top)

2 in PVC  
 (size) (material)

- (6) pump 1 650 W  
 (HP) (yield gpm)

Electric  
 (type power)

- (7) electric log NO  
 (yes or no)

\_\_\_\_\_ (organization running log)

- (8) how well bottom plugged Sand Shale


**DRILLERS REMARKS:**

**RECEIVED**  
**APR 15 1977**

**MISS. BD. OF WATER COMMISSIONERS**

If well telescopes please sketch and show depths.

GROUND LEVEL

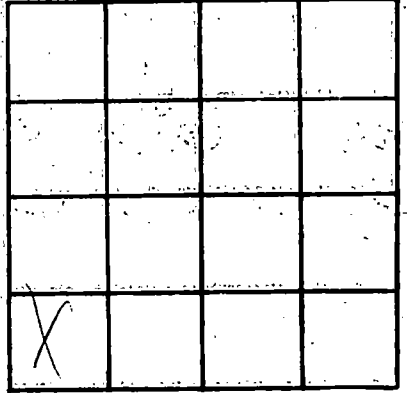

SECTION \_\_\_\_\_

Please indicate well location X.

ADDITIONAL INFORMATION

If more than one screen, show locations of each on sketch.