

Hancock  
A 2018  
1-27-79

MISSISSIPPI  
BOARD OF WATER COMMISSIONERS  
416 North State Street  
Jackson, Mississippi 39201

WATER WELL DRILLERS LOG

1-27-79 date well completed  
BOUNCEY WATER WELL DRILLING firm name  
Hancock county well located

LANDOWNER: Jamaal Jones  
Pass Christian Rd  
White Cypress - Lakes  
(mailing address) Est.

description of formations encountered	from	to
<u>Clay</u>	<u>0</u>	<u>30</u>
<u>Red Soil</u>	<u>30</u>	<u>160</u>
<u>Red Earth</u>	<u>160</u>	<u>174</u>
<u>Clay</u>	<u>174</u>	<u>264</u>
<u>sd. sand.</u>	<u>264</u>	<u>304</u>

WELL LOCATION:  
sec 25 T 5 N R 15 E  
18 miles (distance) S (direction) of P. H. W. (nearest town)

WELL PURPOSE: Flow  
(home, irrigation, municipal, industrial)

- WELL COMPLETION DATA:
- (1) diameter (inches) 4x2
  - (2) total depth (feet) 304
  - (3) static water level (feet) 70 below top of ground.
  - (4) casing PVC (material) 304 (depth)  
4x2 (size) If telescope see back.
  - (5) screen 10 (length) 294 (depth to top)  
2 (size) PVC (material)
  - (6) pump 3/4 HP (HP) 12 (yield gpm)  
AC (type power)
  - (7) electric log / (yes or no)
  - (8) how well bottom plugged Seal.


Miss. Board of Water Comm.

APR 2 1979

DRILLERS REMARKS: Very  
all clay surface  
and blue mud

RECEIVED

If well telescopes please sketch and show depths.

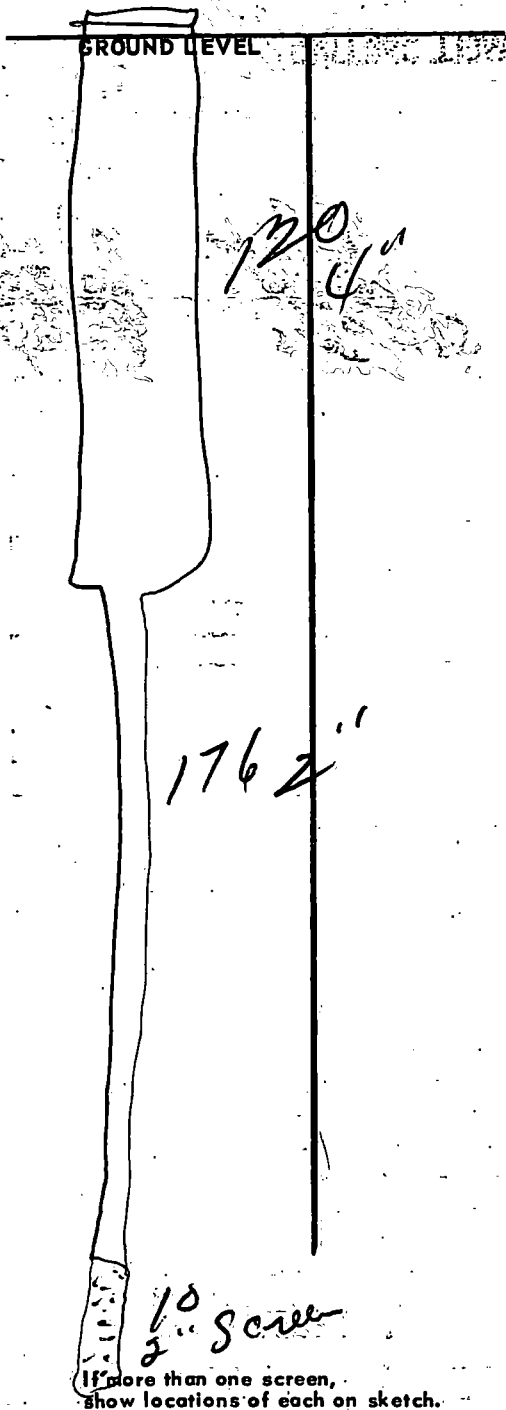


SECTION \_\_\_\_\_

Please indicate well location X.

**ADDITIONAL INFORMATION**


If more than one screen, show locations of each on sketch.