

HANCOCK  
A 2000  
10-1-81

MISSISSIPPI  
 BOARD OF WATER COMMISSIONERS  
 416 North State Street  
 Jackson, Mississippi 39201

WATER WELL DRILLERS LOG

10-1 1981 Peatton Well Serv Hancock  
 date well completed firm name county well located

LANDOWNER: <u>Perry Const</u> <u>1108 Parkwood Cr.</u> <u>Picayune Ms.</u> (mailing address)	description of formations encountered	from	to
	<u>Surface Clay</u>	<u>0</u>	<u>20</u>
	<u>Sand</u>	<u>20</u>	<u>70</u>
	<u>Clay</u>	<u>70</u>	<u>220</u>
	<u>Sand</u>	<u>220</u>	<u>290</u>

WELL LOCATION:  
 sec. 7 T. 5 R. 15  
4 miles East of Coviere  
 (distance) (direction) (nearest town)

WELL PURPOSE: Home  
 (home, irrigation, municipal, industrial)

- WELL COMPLETION DATA:
- (1) diameter (inches) 4
  - (2) total depth (feet) 290
  - (3) static water level (feet) 98 below top of ground.
  - (4) casing PVC, 280  
 (material) (depth)  
4" If telescope see back.  
 (size)
  - (5) screen 10', 280  
 (length) (depth to top)  
2 PVC  
 (size) (material)
  - (6) pump 3/4, 15  
 (HP) (yield gpm)  
Elec  
 (type power)
  - (7) electric log NO  
 (yes or no)

(8) how well bottom plugged BW Value  
 (organization running log)

DRILLERS REMARKS:


DEPT. OF NATURAL RESOURCES  
 BUREAU OF LAND & WATER RESOURCES

OCT 19 1981

RECEIVED

If well telescopes please sketch and show depths.

GROUND LEVEL

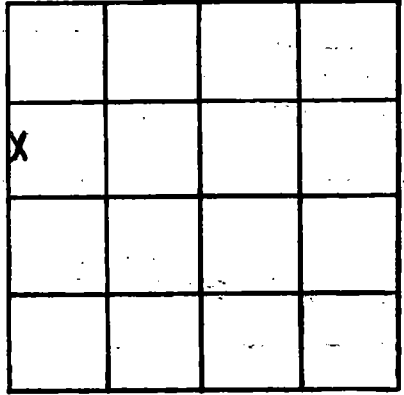

SECTION 7

Please indicate well location X.

ADDITIONAL INFORMATION

If more than one screen, show locations of each on sketch.