

MISSISSIPPI DEPARTMENT OF NATURAL RESOURCES

Bureau of Land and Water Resources

Southport Mall

P.O. Box 10631

Jackson, Mississippi 39209

WATER WELL DRILLERS LOG

BOUNCY WATER WELL DRILLING

Hancock
A 2023

Hancock

2-22-1982
date well completed

firm name

county well located

LANDOWNER: JOE DILLARD
Rt 3 Picayune
MS, 38466
(mailing address)

description of formations encountered

from

to

WELL LOCATION:
sec. 32 N R. 15 E
1.3 miles E of Picayune
(distance) (direction) (nearest town)

Top - 0 18
Sh and junk - 18 50
gravel 50 68
Clay gravel - 68 80
set - 68'

WELL PURPOSE: Home
(home, irrigation, municipal, industrial)

- WELL COMPLETION DATA:
- (1) diameter (inches) 2
 - (2) total depth (feet) 68
 - (3) static water level (feet) 51 ^{below} _{above} top of ground
 - (4) casing PVC 58
(material) (depth)
2 If telescope see back.
(size)
 - (5) screen 10 58
(length) (depth to top)
2 PVC
(size) (material)
 - (6) pump 1 8
(HP) (yield gpm)
AC 220
(type power)
 - (7) electric log /
(yes or no)
(organization running log)
 - (8) how well bottom plugged Sealed

DEPT OF NATURAL RESOURCES
BUREAU OF LAND & WATER RESOURCES

MAR - 3 1982


RECEIVED

DRILLERS REMARKS: Had drilled to 90' on opposite side of house - all junk - moved on approx 150ft.

gravel bed.

If well telescopes please sketch and show depths.

GROUND LEVEL

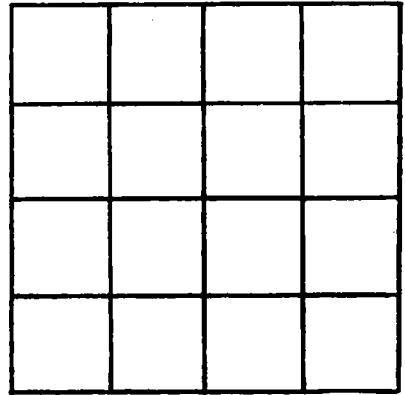

SECTION _____

Please indicate well location X.

ADDITIONAL INFORMATION

If more than one screen, show locations of each on sketch.