

Hancock
A 7024

MISSISSIPPI
BOARD OF WATER COMMISSIONERS
416 North State Street
Jackson, Mississippi 39201

WATER WELL DRILLERS LOG

Hancock
~~Paul River~~

10-9 1982 Benton Well Serv firm name county well located

LANDOWNER: Carl Berry
RT
Carriere, MS.
(mailing address)

description of formations encountered	from	to
Surface Clay	0	15
Sand	15	110
Blue Clay	110	320
Sand	320	450

WELL LOCATION:
sec. 28 T 5 S R 15 W
29 N
12 miles N.E of Picayune
(distance) (direction) (nearest town)

WELL PURPOSE: Home
(home, irrigation, municipal, industrial)

- WELL COMPLETION DATA:
- (1) diameter (inches) 4 x 2
 - (2) total depth (feet) 450
 - (3) static water level (feet) 93 below top of ground.
 - (4) casing PVC, 440 (material), (depth)
 - (size) If telescope see back.
 - (5) screen 10, 440 (length), (depth to top)
 - 2, PVC (size), (material)
 - (6) pump 1, 14 (HP), (yield gpm)
 - Elec (type power)
 - (7) electric log No (yes or no)

(organization running log)
(8) how well bottom plugged BW 1/2 in

DEPT. OF NATURAL RESOURCES
BUREAU OF LAND & WATER RESOURCES


NOV - 8 1982

DRILLERS REMARKS:

RECEIVED

If well telescopes please sketch and show depths.

GROUND LEVEL

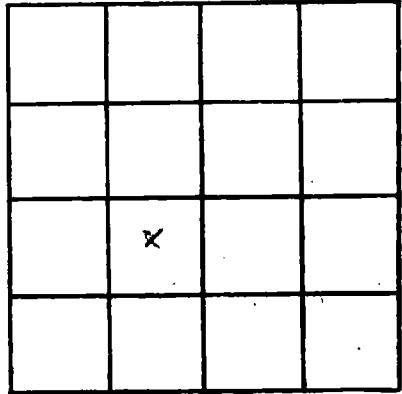

SECTION 29

Please indicate well location X.

ADDITIONAL INFORMATION

If more than one screen, show locations of each on sketch.