

Hancock
A 2025

MISSISSIPPI DEPARTMENT OF NATURAL RESOURCES
 Bureau of Land and Water Resources
 Southport Mall
 P.O. Box 10631
 Jackson, Mississippi 39209
WATER WELL DRILLERS LOG

date well completed 11-27 1982 Hancock county well located

POUNCEY WATER WELL DRILLING

LANDOWNER: Floyd W. Wallace
 (mailing address)
 WELL LOCATION:
 sec. 11 T. 5 N R. 15 E
5 miles NW of NECAISE
 (distance) (direction) (nearest town)
 WELL PURPOSE: Domestic
 (home, irrigation, municipal, industrial)

description of formations encountered	from	to
<u>Top junk</u>	<u>0</u>	<u>80</u>
<u>Soft Brown</u>	<u>80</u>	<u>120</u>
<u>Clay</u>	<u>120</u>	<u>260</u>
<u>Set to 50 gal Ration</u>	<u>260</u>	<u>368</u>


WELL COMPLETION DATA:
 (1) diameter (inches) 2
 (2) total depth (feet) 368
 (3) static water level (feet) 80 below above top of ground.
 (4) casing PVC 368
 (material) (depth)
2 if telescope see back.
 (size)
 (5) screen 10 358
 (length) (depth to top)
2 PVC
 (size) (material)
 (6) pump 1 8
 (HP) (yield gpm)
PC
 (type power)
 (7) electric log No
 (yes or no)
 (organization running log)
 (8) how well bottom plugged Sealed

DRILLERS REMARKS:

RECEIVED
 DEC 20 1982
 BUREAU OF LAND & WATER RESOURCES
 DEPT. OF NATURAL RESOURCES

If well telescopes please sketch and show depths.

GROUND LEVEL

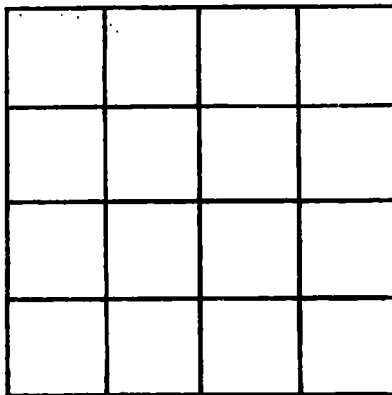

SECTION _____

Please indicate well location X.

ADDITIONAL INFORMATION

If more than one screen, show locations of each on sketch.