

MISSISSIPPI DEPARTMENT OF NATURAL RESOURCES

Bureau of Land and Water Resources

Southport Mall

P.O. Box 10631

Jackson, Mississippi 39209

WATER WELL DRILLERS LOG

HANCOCK
A 2096
3-3-83

POUNCEY WATER WELL DRILLING

Hancock
 county well located

3-3 1983
 date well completed

firm name

LANDOWNER: MR. Victor
Black -
Rt. 3, Picayune, ms.
 (mailing address)

description of formations encountered

from to

WELL LOCATION:
 sec. 32 T 5 N R 15 E
10 miles E of Picayune
 (distance) (direction) (nearest town)

<u>TOP - clay</u>	<u>0</u>	<u>12</u>
<u>sd - junk clay</u>	<u>12</u>	<u>73</u>
<u>Clay</u>	<u>73</u>	<u>357</u>
<u>sd good</u>	<u>357</u>	<u>364</u>
<u>Clay</u>	<u>364</u>	<u>372</u>
<u>sd - very fine</u>	<u>372</u>	<u>386</u>
<u>sd fine</u>	<u>386</u>	<u>398</u>
<u>sd - fine to fair</u>	<u>398</u>	<u>416</u>
<u>sd good</u>	<u>416</u>	<u>434</u>

WELL PURPOSE: Home
 (home, irrigation, municipal, industrial)

WELL COMPLETION DATA:
 (1) diameter (inches) 4x2
 (2) total depth (feet) 434
 (3) static water level (feet) 79 below above top of ground.
 (4) casing PVC 419
 (material) (depth)
4x2 if telescope see back.
 (size)
 (5) screen 15 419
 (length) (depth to top)
2 PVC
 (size) (material)
 (6) pump 1/2 32
 (HP) (yld gpm)
AC
 (type power)
 (7) electric log (yes or no)

DEPT. OF NATURAL RESOURCES
 BUREAU OF LAND & WATER RESOURCES

MAY 18 1983



RECEIVED

Sealed
 how well bottom plugged

DRILLERS REMARKS:

If well telescopes please sketch and show depths.

GROUND LEVEL

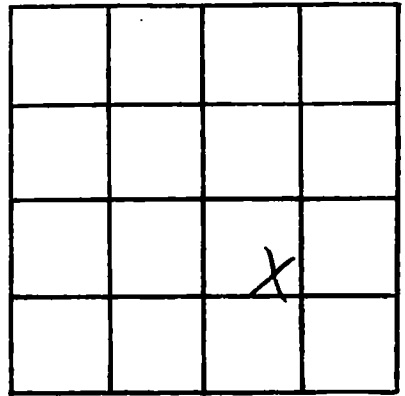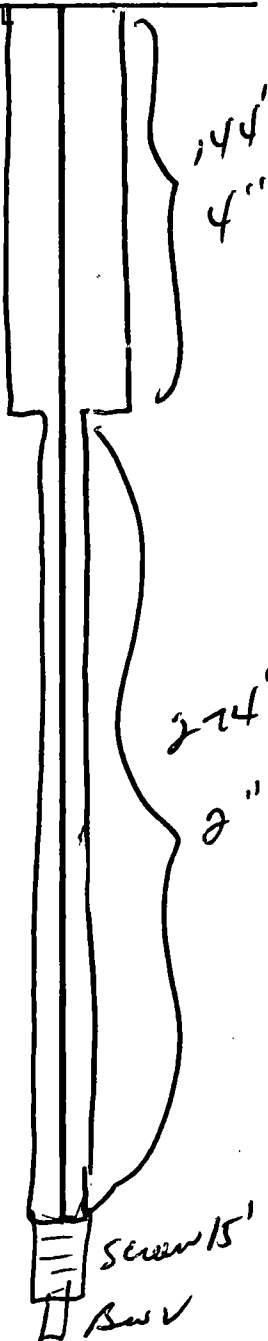

SECTION 32

Please indicate well location X.

ADDITIONAL INFORMATION

If more than one screen, show locations of each on sketch.