

MISSISSIPPI DEPARTMENT OF NATURAL RESOURCES
Bureau of Land and Water Resources
Southport Mall
P.O. Box 10631

Jackson, Mississippi 39209
WATER WELL DRILLERS LOG

POUNCEY WATER WELL DRILLING

Hancock
A 2028

9-16 1983 Pouncey Water Well Drilling Hancock
date well completed firm name county well located

LANDOWNER: Kenny Poda
Rt 3 Leiston
(mailing address)

WELL LOCATION:
sec. 28 T 5 N R 15 E
E W
11 miles E of Picequinn
(distance) (direction) (nearest town)

WELL PURPOSE: Home
(home, irrigation, municipal, industrial)

WELL COMPLETION DATA:

- (1) diameter (inches) 4
- (2) total depth (feet) 405
- (3) static water level (feet) 90 below/above top of ground.
- (4) casing PV 385
(material) (depth)
4 if telescope see back.
(size)
- (5) screen 20 385
(length) (depth to top)
4 PVC
(size) (material)
- (6) pump 1 20
(HP) (yield gpm)
AC
(type power)
- (7) electric log NO
(yes or no)
- (organization running log)
- (8) how well bottom plugged Sealed.

description of formations encountered	from	to
<u>top -</u>	<u>0</u>	<u>8</u>
<u>sd. gravel</u> <u>102 - 112</u>	<u>8</u>	<u>112</u>
<u>clay</u>	<u>112</u>	<u>346</u>
<u>Very fine sd.</u>	<u>346</u>	<u>370</u>
<u>good sd.</u>	<u>370</u>	<u>405</u>


DRILLERS REMARKS:

DEPT. OF NATURAL RESOURCES
BUREAU OF LAND & WATER RESOURCES

JAN 26 1984
RECEIVED

If well telescopes please
sketch and show depths.

GROUND LEVEL

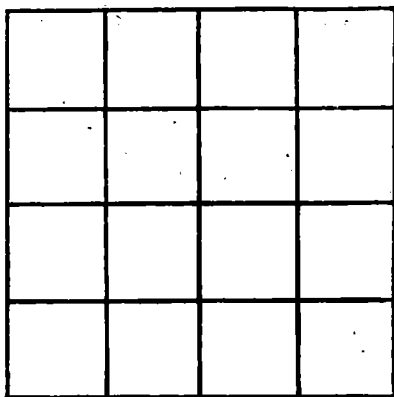

SECTION _____

Please indicate well location X.

ADDITIONAL INFORMATION

If more than one screen,
show locations of each on sketch.