

MISSISSIPPI DEPARTMENT OF NATURAL RESOURCES

Bureau of Land and Water Resources

Southport Mall

P.O. Box 10631

Jackson, Mississippi 39209

WATER WELL DRILLERS LOG

~~XXXXXX~~
LANOCK
A 2052

10/10 1990
date well completed

Bud Penton
firm name

LANOCK
county well located

LANDOWNER: Jal Viola
R.T. 1 Gass Rd 13
(mailing address)

description of formations encountered	from	to
<u>Red shale</u>	<u>0</u>	<u>6</u>
<u>Red sand</u>	<u>6</u>	<u>40</u>
<u>Red shale</u>	<u>40</u>	<u>67</u>
<u>Red sand</u>	<u>67</u>	<u>101</u>

WELL LOCATION:
sec 30 T 5 N R 15 E
S W
12 miles E of Corrigan
(distance) (direction) (nearest town)

WELL PURPOSE: Home
(home, irrigation, municipal, industrial)

- WELL COMPLETION DATA:
- (1) diameter (inches) 4"
 - (2) total depth (feet) 105
 - (3) static water level (feet) 19 below above top of ground.
 - (4) casing PCC, 105,
(material) (depth)
(size) If telescope see back.
 - (5) screen 10, 95
(length) (depth to top)
12, PCC
(size) (material)
 - (6) pump 1, 30
(HP) (yield gpm)
Elect
(type power)
 - (7) electric log no
(yes or no)
 - (organization running log)
 - (8) how well bottom plugged plugged


DRILLERS REMARKS:

RECEIVED
OCT 15 1990

Department of Natural Resources
Bureau of Land & Water Resources

If well telescopes please sketch and show depths.

GROUND LEVEL

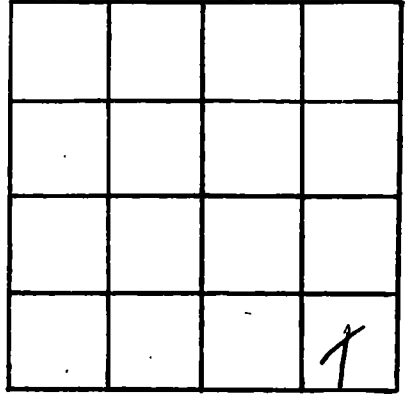

SECTION _____

Please indicate well location X.

ADDITIONAL INFORMATION

A series of horizontal lines for writing additional information, starting below the 'ADDITIONAL INFORMATION' header and extending to the bottom of the page.

If more than one screen, show locations of each on sketch.