

MISSISSIPPI DEPARTMENT OF NATURAL RESOURCES

Bureau of Land and Water Resources

Southport Mall

P.O. Box 10631

Jackson, Mississippi 39209

WATER WELL DRILLERS LOG

Hancock
A 2057

7-8 1992 Bud Penton Water Well Hancock
date well completed firm name county well located

LANDOWNER: Kathrine Kerns

description of formations encountered

from to

31492 Anner Rd Carriere MS

White Shale

0 15

39426

White Sand

15 25

(mailing address)

Blue shale

25 200

WELL LOCATION:

White Sand

200 273

sec. 4 T 5 N R 15 E
S W
9 miles East of Carriere
(distance) (direction) (nearest town)

Blue shale

273 298

Blue Sand

298 432

WELL PURPOSE: Home
(home, irrigation, municipal, industrial)

WELL COMPLETION DATA:

- (1) diameter (inches) 5
(2) total depth (feet) 432
(3) static water level (feet) 116 below above top of ground.

- (4) casing PVC, 422 (material) (depth)
2 (size) If telescope see back.

- (5) screen 10, 422 (length) (depth to top)
2, PVC (size) (material)

- (6) pump 1/2, 5 (HP) (yield gpm)
electric (type power)

- (7) electric log NO (yes or no)

(organization running log)

- (8) how well bottom plugged sandshark

DRILLERS REMARKS:


RECEIVED

AUG 19 1992

Dept. of Environmental Quality
Bureau of Land & Water Resources

If well telescopes please sketch and show depths.

GROUND LEVEL

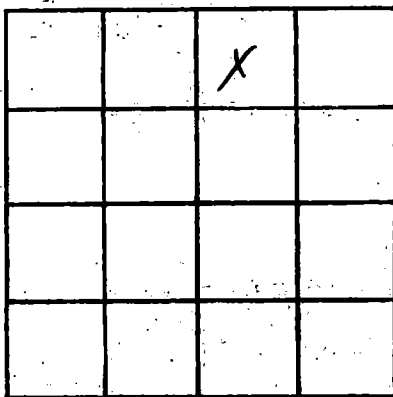

SECTION 4

Please indicate well location X.

ADDITIONAL INFORMATION

Multiple horizontal lines for additional information.

If more than one screen, show locations of each on sketch.