

MISSISSIPPI  
BOARD OF WATER COMMISSIONERS  
416 North State Street  
Jackson, Mississippi 39201

**GOVERNMENT**

WATER WELL DRILLERS LOG

Hancock  
B 2  
2-26-69

2-26 1969 NEIL LUMPKIN WELL DRILLING Hancock  
date well completed firm name SERVICE county well located

LANDOWNER: Johnson, Pharo  
Perkinston, Miss.  
Route 2 Box 116  
(mailing address)

WELL LOCATION:  
sec. 11 T. 5 S. R. 14 E. W.  
4 miles North of Sellers  
(distance) (direction) (nearest town)

WELL PURPOSE: home  
(home, irrigation, municipal, industrial)

WELL COMPLETION DATA:  
(1) diameter (inches) 2"  
(2) total depth (feet) 1766'  
(3) static water level (feet) 2' below top of ground.  
(4) casing galvanize 504' black 1242'  
(material) (depth)  
2" if telescope see back.  
(size)  
(5) screen 20 (length) (depth to top)  
2" (size) Stainless Steel (material)  
(6) pump 3/4 (HP) 1350 gpm (yield gpm)  
electric (type power)  
(7) electric log yes (yes or no)  
(organization running log)

description of formations encountered	from	to
<u>surface clay</u>	<u>0</u>	<u>10</u>
<u>sand &amp; gravel</u>	<u>10</u>	<u>20</u>
<u>Blue Clay</u>	<u>20</u>	<u>100</u>
<u>Good sand</u>	<u>100</u>	<u>230</u>
<u>Blue Clay</u>	<u>230</u>	<u>320</u>
<u>Good sand</u>	<u>320</u>	<u>392</u>
<u>Blue Clay</u>	<u>373</u>	<u>450</u>
<u>Good sand</u>	<u>450</u>	<u>480</u>
<u>Blue clay</u>	<u>430</u>	<u>700</u>
<u>good sand</u>	<u>700</u>	<u>760</u>
<u>Blue clay</u>	<u>760</u>	<u>1340</u>
<u>Good sand</u>	<u>1340</u>	<u>1510</u>
<u>Blue Clay</u>	<u>1510</u>	<u>1770</u>
<u>Good sand</u>	<u>1720</u>	<u>1766</u>

**GOVERNMENT**


MAY 17 1969

OFFICE OF  
WATER CONTROL

DRILLERS REMARKS: Johnson back pressure valve

If well telescopes please sketch and show depths.

GROUND LEVEL

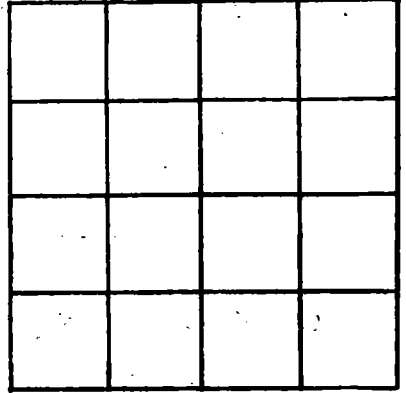

SECTION 11

Please indicate well location X.

**ADDITIONAL INFORMATION**

A series of horizontal lines for recording additional information.

If more than one screen, show locations of each on sketch.