

HANCOCK  
B 7  
3-9-70

MISSISSIPPI  
 BOARD OF WATER COMMISSIONERS  
 416 North State Street  
 Jackson, Mississippi 39201

**CODED**

WATER WELL DRILLERS LOG

March 9 1970 S & S Well Works Hancock  
 date well completed firm name county well located

LANDOWNER: Silva Church  
RT. 2  
Perkinston, Miss  
 (mailing address)

description of formations encountered	depth	
	from	to
<u>top soil</u>	<u>0</u>	<u>2</u>
<u>clay</u>	<u>2</u>	<u>30</u>
<u>sand</u>	<u>20</u>	<u>65</u>

WELL LOCATION:  
 sec. 29 T. 5 N. R. 14 E.  
2 miles S of Teche  
 (distance) (direction) (nearest town)

WELL PURPOSE: Church  
 (home, irrigation, municipal, industrial)

- WELL COMPLETION DATA:
- (1) diameter (inches) 2 in.
  - (2) total depth (feet) 65
  - (3) static water level (feet) 46 below above top of ground.
  - (4) casing P.V.C., 55  
 (material) (depth)
  - 2 in. if telescope see back.  
 (size)
  - (5) screen 10, 55  
 (length) (depth to top)
  - 2 in., P.V.C.  
 (size) (material)
  - (6) pump 1, 5  
 (HP) (yield gpm)
  - 6.  
 (type power)
  - (7) electric log No  
 (yes or no)

**CODED**

(organization running log)

(8) how well bottom plugged B.w.


OCT 2 1970

DRILLERS REMARKS: Done

MISS. BD. OF  
 WATER COMM.

If well telescopes please sketch and show depths.

GROUND LEVEL

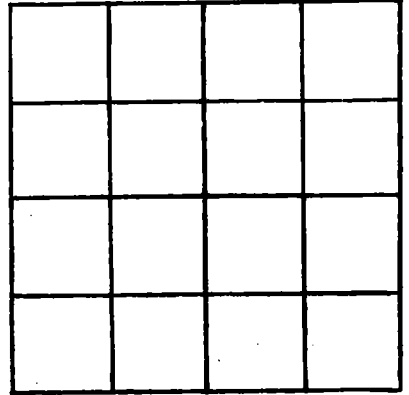

SECTION \_\_\_\_\_

Please indicate well location X.

ADDITIONAL INFORMATION

If more than one screen, show locations of each on sketch.