

HANCOCK
 B 8
 3-12-70

MISSISSIPPI
 BOARD OF WATER COMMISSIONERS
 416 North State Street
 Jackson, Mississippi 39201

CODED

WATER WELL DRILLERS LOG

March 12 1970 S.E. S Well Works Hancock
 date well completed firm name county well located

LANDOWNER: Roger Padon

description of formations encountered

from to

Rt. 1

Pass Christian
 (mailing address)

| | | |
|----------|-----|-----|
| top soil | 0 | 2 |
| clay | 2 | 20 |
| sand | 20 | 60 |
| clay | 60 | 180 |
| sand | 180 | 210 |

WELL LOCATION:

sec. 10 T 5 N R 14 E
 (love) miles S of STANDARDS
 (distance) (direction) (nearest town)

WELL PURPOSE: Home
 (home, irrigation, municipal, industrial)

WELL COMPLETION DATA:

- (1) diameter (inches) 2 in.
- (2) total depth (feet) 210
- (3) static water level (feet) 90 below above top of ground.
- (4) casing M. 200 (material) (depth)
 2 in. (size) if telescope see back.
- (5) screen 10 200 (length) (depth to top)
 2 in. 5.8. (size) (material)
- (6) pump 1 3 (HP) (yield gpm)
 6. (type power)
- (7) electric log No (yes or no)

CODED

(organization running log)

(8) how well bottom plugged B.W.


DRILLERS REMARKS: No Ne

OCT 2 1970

MISS. DEP. OF
 NATURAL RESOURCES

If well telescopes please sketch and show depths.

GROUND LEVEL

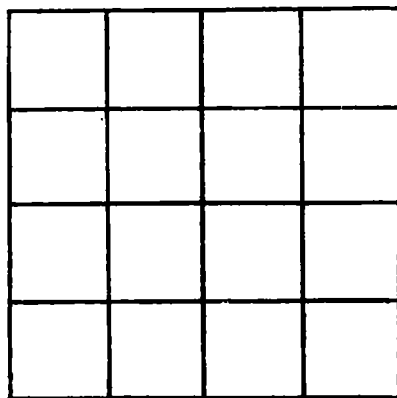

SECTION _____

Please indicate well location X.

ADDITIONAL INFORMATION

If more than one screen, show locations of each on sketch.