

HANCOCK
B10
11-13-70

MISSISSIPPI
 BOARD OF WATER COMMISSIONERS
 416 North State Street
 Jackson, Mississippi 39201

CODED

WATER WELL DRILLERS LOG

11-13 date well completed 1970 Ponton Well Serv⁵⁹ firm name Hancock⁹³ county well located

LANDOWNER: Richard Wheat
Rt. 2 Box 142
Per-Kinston MISS
 (mailing address)

description of formations encountered

from to

Surface clay	0	18
Sand	18	38
White clay	38	56
Mud	56	65
Blue clay	65	205
Sand	205	237

WELL LOCATION:

sec. 19 T. 5 S. R. 14 W.
1 miles SW of Nacaise
 (distance) (direction) (nearest town)

WELL PURPOSE: Home
 (home, irrigation, municipal, industrial)

WELL COMPLETION DATA:

(1) diameter (inches) 4 1/8
2
 (2) total depth (feet) 237
 (3) static water level (feet) 61 below
 top of ground.

(4) casing Galv., 232
 (material) (depth)

2 if telescope see back.
 (size)

(5) screen 5', 232
 (length) (depth to top)

012 2", S. Steel
 (size) (material)

(6) pump 1 10
 (HP) (yield gpm)

Elec
 (type power)

(7) electric log NO
 (yes or no)

(organization running log)

(8) how well bottom plugged B.W. Value

CODED


DEC 8 1970

DRILLERS REMARKS:

MISS. BD. OF
 WATER COMM.

If well telescopes please sketch and show depths.

GROUND LEVEL

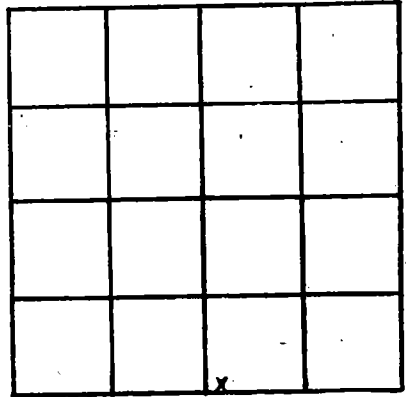

SECTION 19

Please indicate well location X.

ADDITIONAL INFORMATION

If more than one screen, show locations of each on sketch.