

HANCOCK
B 15
12-20-70

MISSISSIPPI
 BOARD OF WATER COMMISSIONERS
 416 North State Street
 Jackson, Mississippi 39201

WATER WELL DRILLERS LOG

CODED

Dec. 20 19 70 S + S well works Hancock
 date well completed firm name county well located

LANDOWNER: Peggie Turner
Rt. 2 Perkinston
Miss
 (mailing address)

description of formations encountered	from	to
<u>top soil</u>	<u>0</u>	<u>3</u>
<u>clay</u>	<u>3</u>	<u>18</u>
<u>sand</u>	<u>18</u>	<u>38</u>
<u>clay</u>	<u>38</u>	<u>200</u>
<u>sand</u>	<u>200</u>	<u>231</u>

WELL LOCATION:
 sec. 5 T. 5 N. R. 14 E
15 miles S of BP
 (distance) (direction) (nearest town)

WELL PURPOSE: Rom^s
 (home, irrigation, municipal, industrial)

WELL COMPLETION DATA:

(1) diameter (inches) 2 1/2
 (2) total depth (feet) 231
 (3) static water level (feet) 110 ^{below} _{above} top of ground.
 (4) casing M (material), 221 (depth)
2 1/2 (size) If telescope see back.
 (5) screen 10 (length), 221 (depth to top)
2 1/2 (size), S.S. (material)
 (6) pump 1 (HP), 5 (yield gpm)
E (type power)
 (7) electric log no (yes or no)
 (organization running log)
 (8) how well bottom plugged BW-

CODED


JAN 21 1971

MISS. BD. OF
 WATER COMM.

DRILLERS REMARKS:
none

If well telescopes please sketch and show depths.

GROUND LEVEL

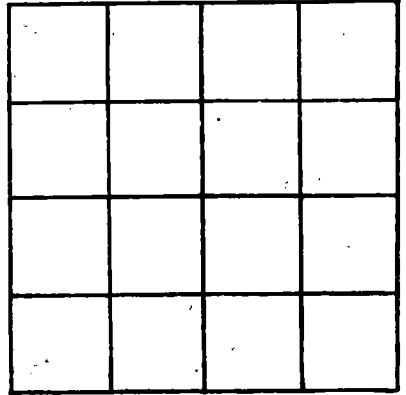

SECTION _____

Please indicate well location X.

ADDITIONAL INFORMATION

If more than one screen, show locations of each on sketch.