

HANCOCK
 B19
 3-4-71

MISSISSIPPI
 BOARD OF WATER COMMISSIONERS
 416 North State Street
 Jackson, Mississippi 39201

CODED

WATER WELL DRILLERS LOG

March 11 1971 SLS Well Works Hancock
 date well completed firm name county well located

LANDOWNER: Randall Neenan
Pt. 2
Perkinston Miss.
 (mailing address)

description of formations encountered	from	to
top sand	0	2
clay	2	98
sand	98	120

WELL LOCATION:
 sec. 10 T. 5 N. R. 14 E
3 miles 5 miles
 (distance) (direction) of (nearest town)

WELL PURPOSE: Home
 (home, irrigation, municipal, industrial)

WELL COMPLETION DATA:

(1) diameter (inches) 2in

(2) total depth (feet) 120

(3) static water level (feet) 30 below above top of ground.

(4) casing 10 110
 (material) (depth)
2in if telescope see back.
 (size)

(5) screen 10 110
 (length) (depth to top)
2in 55
 (size) (material)

(6) pump 1 9
 (HP) (yield gpm)
E
 (type power)

(7) electric log no
 (yes or no)
 (organization running log)

(8) how well bottom plugged B.W.

CODED


MAR 16 1971

MISS. BD. OF
 WATER COM.

DRILLERS REMARKS:
none

If well telescopes please sketch and show depths.

GROUND LEVEL

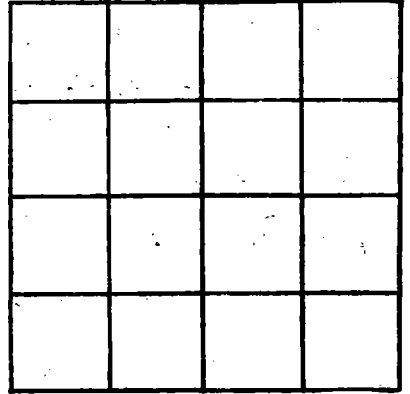

SECTION _____

Please indicate well location X.

ADDITIONAL INFORMATION

If more than one screen,
show locations of each on sketch.