

HANCOCK
B20
12-2-60

MISSISSIPPI BOARD OF WATER COMMISSIONERS

WATER WELL DRILLERS LOG

CODED
County Hancock

Date: 12-2, 1960, Driller: J. Best
(Name)

(1) Owner of Land: D. Lige Curran
(Name)
RT-1 Pass Christian
(Address)
near white cypress Church

(2) Location: $\frac{1}{4}$, $\frac{1}{4}$, Sec 32, T 5 R 14
12 miles North of Velma
(distance) (direction) (Nearest Town)

(3) Topography: (Hilly) (Flat) (Level)

(4) Purpose of Well: Home use
(Domestic Irrigation, Municipal, Industrial, Other)

Description & Color of Materials Sand, Clay, Red Clay, Shell, etc.	Thick- ness Feet	Depth Feet
<u>First 20' Red clay</u>		<u>20</u>
<u>Next 60 " sand</u>		<u>80</u>
<u>111 ft white sand</u>		<u>190</u>
<u>Begin strata</u>	<u>2</u>	<u>30</u>
<u>water</u>		<u>40</u>
<u>Total Dept.</u>	<u>3</u>	<u>70</u>

Information upon completion of well:

(1) Diameter 2" x 1 1/4" inches.

(2) Total Depth 270 feet.

(3) Water Level 70 feet below top of ground.

(4) Cased to _____, Size _____

(5) Screen: Size 1 1/4", Length 10 ft


(6) Were any formations sealed against pollution?
_____ yes, _____ no.

If YES depth of formation _____

Why _____

Drillers Remarks: _____

CODED

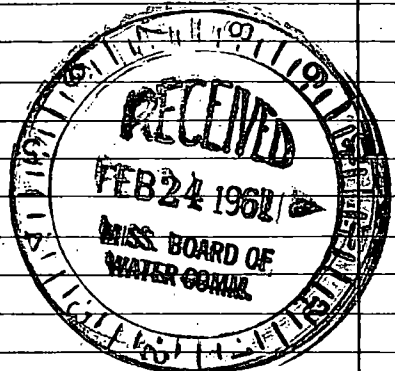

(Use Back Side)

Well No.

2000