

HANCOCK

B21

2-1-64

WATER WELL DRILLERS LOG

CODED

Date: 2-1, 1964, Driller:

(Name)

County Hancock

(1) Owner of Land:

(Name)

(Address)

(2) Location:

SE ¼, SW ¼, Sec. 11 T5R14,

4 miles

(distance)

N

(direction)

Wellton

(Nearest Town)

(3) Topography:

(Hilly)

(Flat)

(Level)

(4) Purpose of Well:

(Domestic Irrigation
Municipal, Industrial, Other)

Information upon completion of well:

(1) Diameter 2" x 1 1/4 inches.

(2) Total Depth 350 feet.

(3) Water Level 21 feet below top of ground.

(4) Cased to _____, Size _____

(5) Screen: Size 1 1/4", Length 15 ft.

(6) Were any formations sealed against pollution?

_____ yes, _____ no.

If YES depth of formation _____


Why _____

Drillers Remarks: _____

Description & Color of Materials
Sand, Clay, Red Clay, Shell, etc.Thick-
ness
FeetDepth
Feet

Description & Color of Materials Sand, Clay, Red Clay, Shell, etc.	Thick- ness Feet	Depth Feet
Red Mud & Sand	120	120
Hard Hard Blue Mud	170	290
Water strata	60	350

CODED

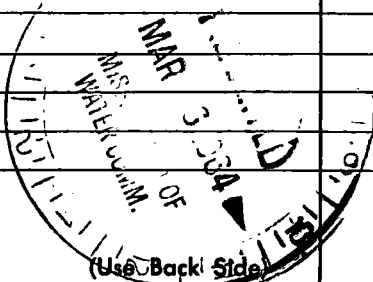

Well No.

