

B22

5-5-64

WATER WELL DRILLERS LOG

**CODED**

Date: May 5, 1964, Driller: J. Beal County: Hancock

(Name)

(1) Owner of Land: Hayward Labrad  
 (Name)  
Rt 2 Chesterton  
 (Address)

Description & Color of Materials Sand, Clay, Red Clay, Shell, etc.	Thick- ness Feet	Depth Feet
<u>Red Mud &amp; sand</u>	<u>130</u>	<u>130</u>
<u>Hard Blue mud</u>	<u>113</u>	<u>243</u>
<u>water sand</u>	<u>30</u>	<u>273</u>

(2) Location: SE 1/4, NE 1/4, Sec. 28 T5 R14  
17 miles N of Tibb  
 (distance) (direction) (Nearest Town)

(3) Topography:  (Hilly)  (Flat)  (Level)


(4) Purpose of Well: Home  
 (Domestic Irrigation  
 Municipal, Industrial, Other)

**CODED**

Information upon completion of well:

- (1) Diameter: 2 1/4 inches.
- (2) Total Depth: 273 feet.
- (3) Water Level: 80 feet below top of ground.
- (4) Cased to \_\_\_\_\_, Size \_\_\_\_\_.
- (5) Screen: Size 1 1/4", Length 15".
- (6) Were any formations sealed against pollution?  
 \_\_\_\_\_ yes, \_\_\_\_\_ no.

If YES depth of formation \_\_\_\_\_  
 Why \_\_\_\_\_  
 Drillers Remarks: \_\_\_\_\_

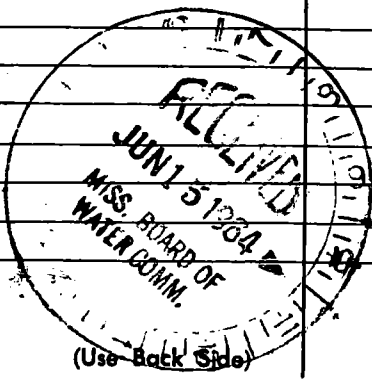

Well No.

1000

1000

