

B25

9-15-60

WATER WELL DRILLERS LOG

CODED

Date: Sept 15, 1960, Driller: Leo Fisher County Hancock
(Name)

(1) Owner of Land: Lynn Shaw
(Name)
Popkinator Miss
(Address)

(2) Location: 1/4, 1/4, Sec. 10 T5R14,
20 miles south of Popkin
(distance) (direction) (nearest Town)

(3) Topography: _____
(Hilly) (Flat) (Level)

(4) Purpose of Well: Home Use
(Domestic Irrigation
Municipal, Industrial, Other)

Description & Color of Materials Sand, Clay, Red Clay, Shell, etc.	Thick- ness Feet	Depth Feet
<u>Clay</u>	<u>15</u>	<u>19-18</u>
<u>Sand</u>	<u>7</u>	<u>15-22</u>
<u>Blue Clay</u>	<u>28</u>	<u>22-100</u>
<u>Sand</u>	<u>80</u>	<u>100-180</u>

Information upon completion of well:

(1) Diameter 2 inches.

(2) Total Depth 180 feet.

(3) Water Level 15 feet below top of ground.

(4) Cased to 168 ft Size 2' x 1 1/4'

(5) Screen: Size 1 1/4' x 60' Ha, Length 12 ft.

(6) Were any formations sealed against pollution?
_____ yes, no.


CODED

17-18 14-15
19-20 - 21-22

If YES depth of formation _____

Why _____

Drillers Remarks: _____

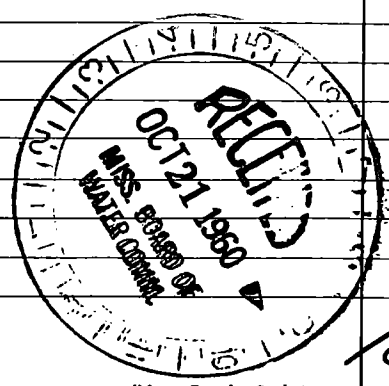

(Use Back Side)

Well No. 10

