

B26  
9-17-60

WATER WELL DRILLERS LOG

**CODED**

Date: Sept 17, 1960, Driller: Leo Fisher County Hancock  
(Name)

(1) Owner of Land Calvin Shaw  
(Name)  
Robertson Miss  
(Address)  
(2) Location: 1/4, 1/4, Sec. 21 T 5 R 4,  
19 miles Southeast of Poplarville  
(direction) (direction) (Nearest Town)  
(3) Topography: 33  
(Hilly) (Flat) (Level)  
(4) Purpose of Well: Domestic Use  
(Domestic Irrigation  
Municipal, Industrial, Other)


Description & Color of Materials Sand, Clay, Red Clay, Shell, etc.	Thick- ness Feet	Depth Feet
<u>Clay - white</u>	<u>35</u>	<u>0-30</u>
<u>Sand</u>	<u>25</u>	<u>35-60</u>

Information upon completion of well:

- (1) Diameter 2 inches.
- (2) Total Depth 60 feet.
- (3) Water Level 35 feet below top of ground.
- (4) Cased to 55, Size 2"
- (5) Screen: Size 60 Ho, Length 5
- (6) Were any formations sealed against pollution?  
\_\_\_\_\_ yes,  no.

**CODED**

If YES depth of formation \_\_\_\_\_  
Why \_\_\_\_\_  
Drillers Remarks: \_\_\_\_\_

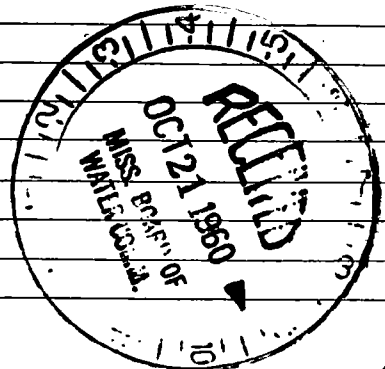

(Use Back Side)

Well No. 11

Faint, illegible text at the top of the page, possibly a header or title.

Main body of faint, illegible text, appearing to be several lines of a document or letter.

Faint, illegible text at the bottom of the page, possibly a footer or signature area.