

B 27
12-20-60

WATER WELL DRILLERS LOG

CODED

Date: 12-20, 1960, Driller: J. Reed County Hancock
(Name)

- (1) Owner of Land: Hayward Ladner
(Name)
Rt 2 Box 138 Perkinston
on Highway 203 28
(Address)
- (2) Location: 1/4, 1/4, Sec. 29 T5 R14,
12 miles North of Kuhn
(distance) (direction) (Nearest Town)
- (3) Topography: (Hilly) (Flat) (Level)
- (4) Purpose of Well: Home
(Domestic Irrigation, Municipal, Industrial, Other)

Description & Color of Materials Sand, Clay, Red Clay, Shell, etc.	Thick- ness Feet	Depth Feet
Red Clay		12
Red sand		50
Red Blue Clay		
Blue Clay		177
Shatta		40
Total Dept		277


Information upon completion of well:

- (1) Diameter 2" x 1/4" inches.
- (2) Total Depth 277 feet.
- (3) Water Level 70 feet below top of ground.
- (4) Cased to _____, Size _____
- (5) Screen: Size 1/4", Length 10 ft.
- (6) Were any formations sealed against pollution?
_____ yes, _____ no.

If YES depth of formation _____
Why _____

Drillers Remarks: _____

CODED

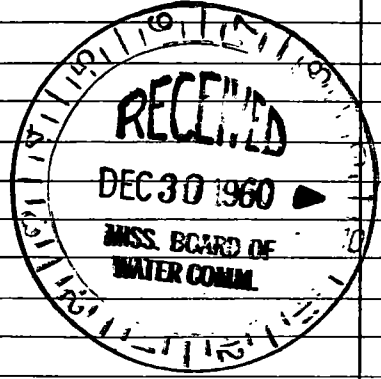

(Use Back Side)

Well No.

