

HANCOCK
B 34
10-20-71

MISSISSIPPI
 BOARD OF WATER COMMISSIONERS
 416 North State Street
 Jackson, Mississippi 39201

NOV 22 1971

WATER WELL DRILLERS LOG **CODED**


Oct. 20 1971 SLS Small works Hancock
 date well completed firm name county well located

LANDOWNER: Charles Shree Pt 2	description of formations encountered	from	to
Derbinston, Miss. (mailing address)	top soil	0	2
WELL LOCATION: sec. 3 T. 5 N R. 14 E	clay	2	20
miles 5 of Crane Creek (distance) (direction) (nearest town)	sand	20	70
WELL PURPOSE: Home (home, irrigation, municipal, industrial)	Clay	70	139
WELL COMPLETION DATA:	sand	139	158
(1) diameter (inches) 2 in.	CODED		
(2) total depth (feet) 158			
(3) static water level (feet) 100 - below top of ground.			
(4) casing 2 in. (material) 148 (depth)			
2 in. (size) If telescope see back.			
(5) screen 10 (length) 148 (depth to top)			
2 in. (size) 56 PVC, 54 SS. (material)			
(6) pump 1 (HP) 5 (yield gpm)			
E (type power)			
(7) electric log no (yes or no)			
(organization running log)			
(8) how well bottom plugged Brai			
DRILLERS REMARKS:			
Man			


If well telescopes please sketch and show depths.



GROUND LEVEL

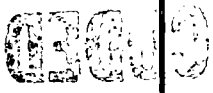

If more than one screen, show locations of each on sketch.

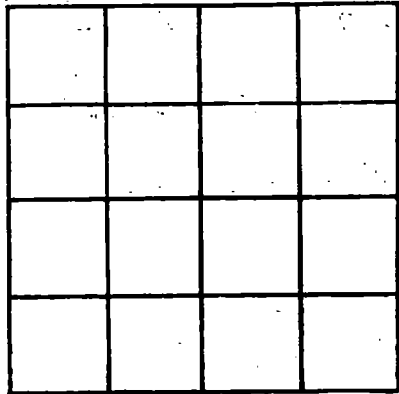

SECTION _____

Please indicate well location X.

ADDITIONAL INFORMATION

Lined area for providing additional information, consisting of multiple horizontal lines.