

Hancock
B 44
10-15-72

MISSISSIPPI
 BOARD OF WATER COMMISSIONERS
 416 North State Street
 Jackson, Mississippi 39201
 WATER WELL DRILLERS LOG

CODED

Oct. 15 1972 S+S Wellworks Hancock
 date well completed firm name county well located

LANDOWNER: W. R. Mills
Rt. 2 Perkinston
Miss.
 (mailing address)

description of formations encountered	from	to
<u>topsoil</u>	<u>0</u>	<u>3</u>
<u>Clay</u>	<u>3</u>	<u>81</u>
<u>sand</u>	<u>81</u>	<u>91</u>

WELL LOCATION:
 sec. 18 T 5 N R 14 E
 (distance) miles (direction) of (nearest town)

WELL PURPOSE: Home
 (home, irrigation, municipal, industrial)

- WELL COMPLETION DATA:
- (1) diameter (inches) 2
 - (2) total depth (feet) 91
 - (3) static water level (feet) 40 below above top of ground.
 - (4) casing P.V.C. 81
 (material) (depth)
2 (size) if telescope see back.
 - (5) screen 10 81
 (length) (depth to top)
2 (size) P.V.C. (material)
 - (6) pump 1 5
 (HP) (yield gpm)
E (type power)
 - (7) electric log no
 (yes or no)
 (organization running log)
 - (8) how well bottom plugged Bar-

CODED

NOV - 9 1972

DRILLERS REMARKS:
none

MISS. RD. OF
 WATER COMM.

If well telescopes please sketch and show depths.

GROUND LEVEL

2181

0381


advised

long

fast

and

CODED

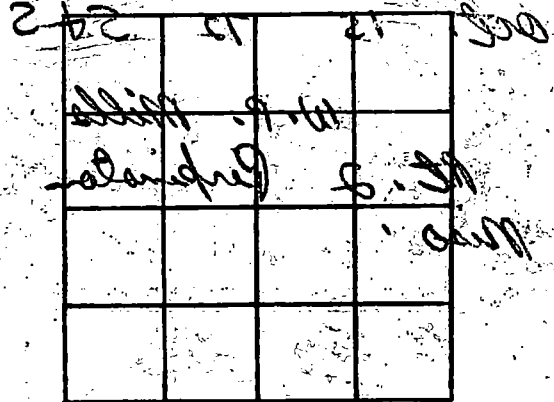

LOCATION

Please indicate well location X.

ADDITIONAL INFORMATION

11

21

NO

31

31

8

10

8

1

8

11

31

If more than one screen, show locations of each on sketch.

W. Hill