

HANCOCK
B 46
12-29-72

MISSISSIPPI
 BOARD OF WATER COMMISSIONERS
 416 North State Street
 Jackson, Mississippi 39201

CODED

WATER WELL DRILLERS LOG


Dec 29 1972 S & S Hancock
 date well completed firm name county well located

LANDOWNER: <u>Hulon C. ...</u>	description of formations encountered	from	to
<u>RT 2</u> <u>Perkinston Miss.</u> (mailing address)	<u>Top Soil</u>	0	2
WELL LOCATION: sec. <u>18</u> T. <u>5</u> N. R. <u>14</u> E.	<u>Clay</u>	2	20
(distance) miles of (direction) of (nearest town)	<u>sand</u>	30	70
WELL PURPOSE: <u>Home</u> (home, irrigation, municipal, industrial)	<u>Clay</u>	70	90
WELL COMPLETION DATA:	<u>Sand</u>	260	231
(1) diameter (inches) <u>2"</u>			
(2) total depth (feet) <u>231</u>			
(3) static water level (feet) <u>80</u> below above top of ground			
(4) casing <u>P.V.C.</u> <u>221</u> (material) (depth) <u>2"</u> (size) If telescope see back.			
(5) screen <u>10'</u> <u>231</u> (length) (depth to top)			
<u>2"</u> <u>P.V.C.</u> (size) (material)			
(6) pump <u>1</u> <u>6</u> (HP) (yield gpm)			
<u>E.</u> (type power)			
(7) electric log <u>NO</u> (yes or no)			
(organization running log)			
(8) how well bottom plugged <u>BW.</u>			
DRILLERS REMARKS:			

CODED

If well telescopes please sketch and show depths.

GROUND LEVEL

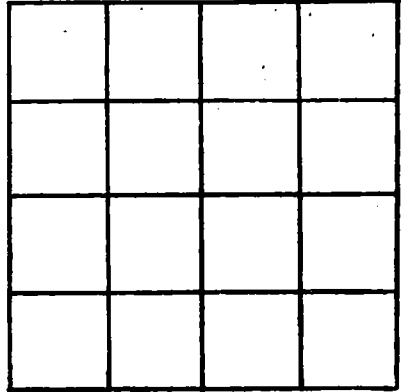

SECTION _____

Please indicate well location X.

ADDITIONAL INFORMATION

If more than one screen, show locations of each on sketch.