

**HANCOCK**  
**B 48**  
**1-18-73**

MISSISSIPPI  
 BOARD OF WATER COMMISSIONERS  
 416 North State Street  
 Jackson, Mississippi 39201

**CODED**

WATER WELL DRILLERS LOG

Jan 18 19 73 S & S Well Co. Hancock  
 date well completed firm name county well located

LANDOWNER: <u>Jim Smith</u>	description of formations encountered	from	to
<u>P.O. Box</u> <u>Perkinston, Miss</u> (mailing address)			
	<u>top soil</u>	<u>0</u>	<u>3</u>
	<u>clay</u>	<u>3</u>	<u>120</u>
	<u>drill</u>	<u>120</u>	<u>160</u>

WELL LOCATION:  
 sec. 19 T. 5 N. R. 14 E.  
 miles of Perkins  
 (distance) (direction) (nearest town)

WELL PURPOSE: Home  
 (home, irrigation, municipal, industrial)


- WELL COMPLETION DATA:
- (1) diameter (inches) 4
  - (2) total depth (feet) 160
  - (3) static water level (feet) 40' below above top of ground.
  - (4) casing PVC. 140'  
 (material) (depth)  
4 if telescope see back.  
 (size)
  - (5) screen 20' 140  
 (length) (depth to top)  
4 PVC.  
 (size) (material)
  - (6) pump 1 20  
 (HP) (yield gpm)  
Ec.  
 (type power)
  - (7) electric log No  
 (yes or no)
- (organization running log)
- (8) how well bottom plugged B.W.

**CODED**

DRILLERS REMARKS: \_\_\_\_\_

If well telescopes please sketch and show depths.

GROUND LEVEL

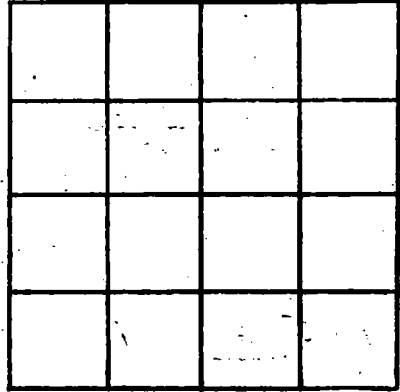

SECTION \_\_\_\_\_

Please indicate well location X.

ADDITIONAL INFORMATION

If more than one screen, show locations of each on sketch.