

HANCOCK
B 50
3-30-73

MISSISSIPPI
 BOARD OF WATER COMMISSIONERS
 416 North State Street
 Jackson, Mississippi 39201

CODED

WATER WELL DRILLERS LOG

3-30- 1973 Lumpkin Well Sec Hancock
 date well completed firm name county well located

LANDOWNER: Larry Pearson
McCaiss, Miss.
 (mailing address)
 WELL LOCATION:
 sec. 8 T-5 N R-14 E
2.5 miles N of McCaiss
 (distance) (direction) (nearest town)

description of formations encountered	from	to
<u>Surface Clay</u>	<u>0</u>	<u>13</u>
<u>Surface Sand + Gravel</u>	<u>15</u>	<u>80</u>
<u>Blue Clay</u>	<u>80</u>	<u>180</u>
<u>Good sand</u>	<u>180</u>	<u>216</u>

WELL PURPOSE:
 (home, irrigation, municipal, industrial)

WELL COMPLETION DATA:
 (1) diameter (inches) 2 "
 (2) total depth (feet) 216
 (3) static water level (feet) 10 below above top of ground.
 (4) casing galv. 210
 (material) (depth)
 (size) If telescope see back.
 (5) screen 5' 2"
 (length) (depth to top) (size) S. Steel (material)
 (6) pump 1 Get 450 gal.
 (HP) (yield gpm) per hr.
electric
 (type power)
 (7) electric log _____
 (yes or no)


 (organization running log)
 (8) how well bottom plugged Johnson
Back Pressure Valve

CODED

DRILLERS REMARKS:

If well telescopes please sketch and show depths.

GROUND LEVEL

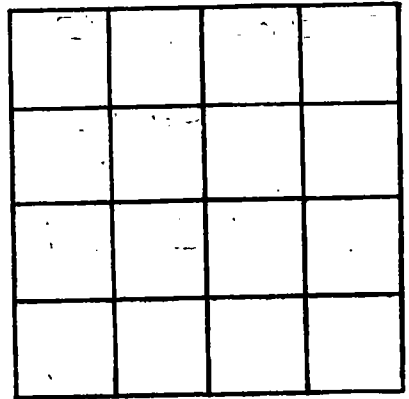

SECTION _____

Please indicate well location X.

ADDITIONAL INFORMATION

If more than one screen,
show locations of each on sketch.