

Hancock

B52

11-16-73

MISSISSIPPI BOARD OF WATER COMMISSIONERS 416 North State Street Jackson, Mississippi 39201

WATER WELL DRILLERS LOG

CODED

11-16 date well completed

1973 McGill Well Works firm name

Hancock county well located

LANDOWNER: Leonard Strong

Pl. 1, Box 388

Bay St. Louis Mo. (mailing address)

WELL LOCATION:

sec 5 T 9 N R 4 E 2 miles N of Waveland (distance) (direction) (nearest town)

WELL PURPOSE: none (home, irrigation, municipal, industrial)

WELL COMPLETION DATA:

- (1) diameter (inches) 2"
(2) total depth (feet) 262'
(3) static water level (feet) 3' below top of ground
(4) casing gal. 252' (material) (depth)
(5) screen 10' (length) (depth to top) 2" (size) 2.5 (material)
(6) pump 1 1/2 (HP) 16 (yield gpm) electric (type power)
(7) electric log (yes or no)
(8) how well bottom plugged sand stone

description of formations encountered

from to


Table with 2 columns: description of formations encountered, from, to. Rows include Sand, Clay, Silty clay, Fine sand, coarse sand with depth ranges.

CODED

DRILLERS REMARKS:

If well telescopes please sketch and show depths.

GROUND LEVEL

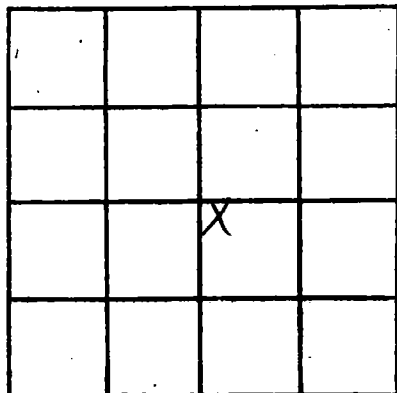

SECTION 5

Please indicate well location X.

ADDITIONAL INFORMATION

If more than one screen, show locations of each on sketch.