

Hancock
 B 54
 8/13/74

MISSISSIPPI
 BOARD OF WATER COMMISSIONERS
 416 North State Street
 Jackson, Mississippi 39201

CODED

WATER WELL DRILLERS LOG

8/13/74 date well completed 1974 Pinedale Water Well Hancock firm name Hancock county well located

LANDOWNER: J.C. Fisher
 Orange Grove Rd.
 Sulfur Miss.
 (mailing address)

description of formations encountered	from	to
red clay	0	80'
white clay	80	140
blue pipe clay	140	230
pepper sand clay	230	265

WELL LOCATION:
 sec 19 T 5 S R 14 E 13 S
 2 miles West of Nemo
 (distance) (direction) (location)

WELL PURPOSE: home
 (home, irrigation, municipal, industrial)

- WELL COMPLETION DATA:
- (1) diameter (inches) 2
 - (2) total depth (feet) 265
 - (3) static water level (feet) 60 below top of ground
 - (4) casing PVC 255
 (material) (depth)
2 if telescope see back.
 (size)
 - (5) screen 10 255
 (length) (depth to top)
2 PVC fabric
 (size) (material)
 - (6) pump 1 8
 (HP) (yield gpm)
Elect
 (type power)
 - (7) electric log W
 (yes or no)
W
 (organization running log)
 - (8) how well bottom plugged plugged
plugged


DRILLERS REMARKS: _____

RECEIVED
 JUN 19 1975

MISS. BD. OF WATER COMMISSIONERS

If well telescopes please sketch and show depths.

GROUND LEVEL

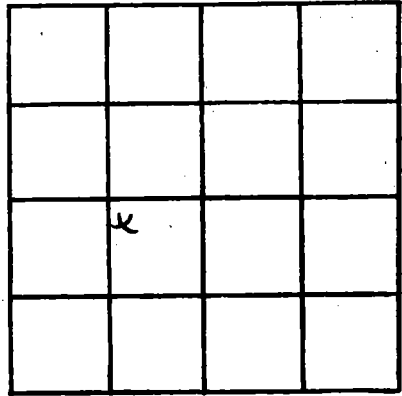

SECTION 19

Please indicate well location X.

ADDITIONAL INFORMATION

If more than one screen, show locations of each on sketch.