

MISSISSIPPI DEPARTMENT OF NATURAL RESOURCES
Bureau of Land and Water Resources

COUNTY WELL LOCATED
Flomenville

WELL NUMBER CODED
B 58

DATE WELL COMPLETED
9-2-87

PERMIT NUMBER
POUNCEY WATER WELL DRILLING

NAME OF DRILLING FIRM
ROUTE 3, BOX 461

PICAYUNE, MS. 39466

P.O. Box 10631
Jackson, Mississippi 39209
WATER WELL DRILLERS LOG

NAME & MAILING ADDRESS OF LANDOWNER
Sharon Murphy

WELL LOCATION: SEC TOWNSHIP RANGE
5 S 14 E

DISTANCE DIRECTION NEAREST TOWN
4 1/2 Miles NW of Pouncey

OTHER LANDMARK
Old Seelye water pond

WELL PURPOSE: Home, Irrigation, Municipal, Industrial, Fish Pond, etc.
Home

PUMP DATA

PUMP TYPE (Circle One):
Submersible, Turbine, Jet, Flowing Well, Other (Describe) _____

POWER TYPE (Circle One):
 Electric, Tractor, Diesel, Gasoline, Butane, Other (Describe) _____

Pump Capacity (GPM)	No. of Stages	Setting Depth
<i>12H</i>	<i>3</i>	<i>100'</i> FT.

PUMP TEST

Well yielded *12* GPM with a drawdown of _____ ft. after _____ hours of pumping

WELL DATA

Well Depth <i>1060</i>	Casing Diameter (In.) <i>2</i>	Casing Length (Ft.) <i>1040</i>
Type of Casing <i>Pvc</i>	Hole Depth <i>1060</i>	Depth to Static Water Level <i>82'</i>

TYPE OF COMPLETION: (Circle One or More):
 Gravel Packed, Underreamed, Telescoped, Natural Development, Open Hole, Other (Describe) _____

Top of Lap Pipe or Reduction in Casing
FEET IF TELESCOPED OR MORE THAN ONE SCREEN: USE BACK PAGE

LOG DATA

TYPE OF LOG RUN (Circle One):
No Log Run, Electric, Gamma Ray, Density, Sonic, Neutron, Other (Describe) _____

Name of Organization Running Log

SCREEN DATA

Diameter - Inches <i>2</i>	Length - Feet <i>20</i>	Slot Size - Inches <i>10/12, 1/16, 5/16</i>
Screen Type <i>Pvc wrap</i>	Depth to Bottom - Feet <i>1060</i>	

GEOLOGIC DATA (Office Use Only)

Surface Elev.	Geologic Unit	Unit Thickness	Depth to Top
Subs. SWL	Date	Analysis	Aquifer Test

Driller's Remarks
Log 1018-1021

DESCRIPTION OF FORMATIONS ENCOUNTERED	FROM	TO	FORMA	TO
<i>TOP</i>	<i>0</i>	<i>18</i>	<i>SD</i>	<i>20</i>
<i>Joint Red</i>	<i>18</i>	<i>30</i>	<i>SD</i>	<i>30</i>
<i>Clay</i>	<i>30</i>	<i>192</i>	<i>HD HD</i>	<i>996</i>
<i>6 ft on set SD.</i>	<i>192</i>	<i>500</i>	<i>SD</i>	<i>996-1060</i>
<i>good sd.</i>	<i>467</i>	<i>500</i>		
<i>HD Clay Swm.</i>	<i>500</i>	<i>880</i>		


IF MORE SPACE IS NEEDED, USE BACK

RECEIVED

Department of Natural Resources
Bureau of Land & Water

If well telescopes please sketch and show depths.

GROUND LEVEL

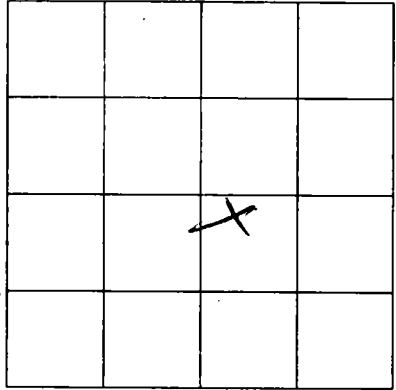

SECTION _____

Please indicate well location X.

ADDITIONAL INFORMATION

Lined area for additional information.

If more than one screen, show location of each on sketch.