

Hancock

# STATE WELL REPORT

## Part 1

### Driller's Log

Mississippi Department of Environmental Quality  
Office of Land and Water Resources  
P.O. Box 2309  
Jackson, MS 39225-2309  
(601)961-5210  
(601)360-0535 (fax)

### For Office Use Only:

Well #: B65  
Aquifer: \_\_\_\_\_  
E-Log #: \_\_\_\_\_

County: Harrison  
 Permit #: 0239  
 Driller: McGill pump & well  
 Date drilling completed: 12-19-16

State Law requires that this report be prepared by the license holder responsible for the work and filed with the Department at the above address within 30 days of completion of drilling of the well or borehole.

Well Owner Information (Landowner if borehole is not for a water well)	Well or Borehole Location
Owner Name: <u>Jay Ladner</u>	Latitude: <u>30° 34' 23.12" N</u> Longitude: <u>89° 26' 6.58" W</u>
Mailing Address: <u>7168 Wendell Ladner Rd</u>	Method of Lat/Long (check one): Conventional Survey _____
<u>Perkinston</u> MS <u>39573</u>	USGS quad _____, Hand-held GPS <input checked="" type="checkbox"/> , Survey-grade GPS _____
City State Zip Code	<u>SE 1/4 SW 1/4, Sec 04 30 T5S R14W</u>
Telephone No. <u>(228) 493-4378</u>	<u>1.5</u> Miles <u>NE</u> of <u>McCaig</u>
	(Distance) (Direction) (Nearest Town)

**Well / Borehole Data**

Date drilling started: 12-19-16 Date drilling completed: 12-19-16 Hole depth: 240 Hole diameter: 4x2

Location of the source of any surface water used for drilling: well water

Method of dosing and volume of Chlorine used in drilling and development: N/A

Logs run (circle all applicable):  No log run  Electric  Gamma Ray  Density  Sonic  Neutron  Other: \_\_\_\_\_

Name of organization running log(s): N/A

Purpose of borehole (circle one):  Water Well  Geotechnical/Geological Investigation  Ground Source Heat Pump  
 Seismic Survey  Other (describe) \_\_\_\_\_

*If drilling is not related to water well construction, skip the remainder of this block*

Purpose of Well (circle all applicable):  Home  Industrial  Public Supply  Irrigation  Fish Culture

Other (describe): \_\_\_\_\_

If a flowing well, method of flow regulation: Valve \_\_\_\_\_ Other (describe) Back wash valve

Static Water Level: 90 feet [above or  below] land surface Date measured: 12-21-16

Method of measurement (circle one):  Steel tape  Electric tape  Air line  Other (describe): \_\_\_\_\_

Well depth: 240 Well grouted to a depth of: 10 feet Type of grout (circle one): Neat Cement  Bentonite  Mix

Casing length: 220 feet Casing diameter: 4x2 inches Type of casing: pvc

Screen length: 20 feet Screen diameter: 2" inches Type of screen: pvc

Screen slot size: .006 inches Setting depth: From 220 feet to 240 feet

Type of completion (circle all applicable): Gravel packed  Underreamed  Open hole  Natural Development

Other (describe): \_\_\_\_\_

Top of lap pipe or reduction in casing: 220 feet

*If telescoped or more than one screen, describe on next page*

RECEIVED  
JAN 23 2017

# STATE WELL REPORT

## Part 2

**Pump Installer's Completion Report**  
 Mississippi Department of Environmental Quality  
 Office of Land and Water Resources  
 P.O. Box 2309  
 Jackson, MS 39225-2309  
 (601)961-5210  
 (601) 360-0535 (fax)

**For Office Use Only:**

Well #: B65  
 Aquifer: \_\_\_\_\_

County: Harrison Hancock  
 Permit #: 0239  
 Driller: McGill Pump Well  
 Date completed: 12-19-16  
 Copy information from block on Part 1

*This part of the report must be completed by a licensed water well contractor or a licensed pump installer. A copy of Part 1 of the report must be attached and both parts filed with the Department at the above address within 30 days of well completion.*

Well Owner Information	Well Location
Owner Name: <u>Jay Ladner</u>	Latitude: <u>30° 34' 33.12" N</u> Longitude: <u>89° 26' 6.58" W</u>
Mailing Address: <u>7168 Wendell Ladner Rd</u>	Method of Lat/Long (check one): Conventional Survey _____, USGS quad _____, Hand-held GPS <input checked="" type="checkbox"/> , Survey-grade GPS _____
<u>Derkinston</u> <u>MS</u> <u>39573</u>	<u>SE 1/4 SW 1/4, Sec. 04<sup>30</sup> T5S R14W</u>
City State Zip Code	<u>1.5</u> Miles <u>NE</u> of <u>DeCade</u>
Telephone No. <u>(228) 493-4378</u>	(Distance) (Direction) (Nearest Town)

**Pump Type (circle one)**

Submersible Turbine Air Lift Centrifugal Flowing Well Jet Piston Rotary Other (describe): \_\_\_\_\_

Date Pump Installed: 12-21-16 Rated Pump Capacity: 25 Gallons Per Minute

Is This Pump (circle one): New Repaired Replacement

**Power Type (circle one)**

Electric Diesel Gasoline Natural Gas Tractor PTO Windmill Other (describe): \_\_\_\_\_

Horse Power Rating of Motor: 1 1/2 Setting Depth: 160 feet Number of Stages: 10

**Pump Test Data for Non Flowing Well**

Date Well Tested: 12-19-16 Duration of Pump Test (minimum 4 hours): 4 hours

Static Water Level (A): 90 Feet Below Land Surface Pumping Water Level (B): 160 Feet Below Land Surface

Drawdown [(B) - (A)]: 5 Feet Below Land Surface Test Pumping Rate: 40 Gallons Per Minute

Method of measurement (circle one):  Steel tape  Electric tape  Air line Other (describe): \_\_\_\_\_

**Pump Test Data for Flowing Well** NA

Measured shut in head: \_\_\_\_\_ feet.

Well yielded \_\_\_\_\_ GPM with a drawdown of \_\_\_\_\_ feet after \_\_\_\_\_ hours of pumping

**Meter Installation** NA

Meter Manufacturer: \_\_\_\_\_ Meter Serial Number: \_\_\_\_\_

Meter Model Number/Name: \_\_\_\_\_ Type of Meter: \_\_\_\_\_

Totalizer Register Unit and Multiplier Factor (AF x .001, gal x 1000, etc): \_\_\_\_\_

Installation Date: \_\_\_\_\_ Meter installed by: \_\_\_\_\_

Is This Meter (circle one): New Repaired Replacement

*Important: By submitting the above information you are certifying that this meter was installed to manufacturer standards. For agricultural wells, a list of approved meters is on the MDEQ website.*

I HEREBY CERTIFY that the above statements are true to the best of my knowledge.



Michael McCall 84-0239 118117 [Signature]  
 Print Name of Pump Installer and License No. (if applicable) Date Signature of Pump Installer

RECEIVED  
 JAN 23 2017  
 Form: OLWR-SWR-2A (4713)

BY OLWR



Back of house  
7168 Wendell Ladner  
7168 Wendell Ladner  
B65  
X  
7168 Wendell Ladner

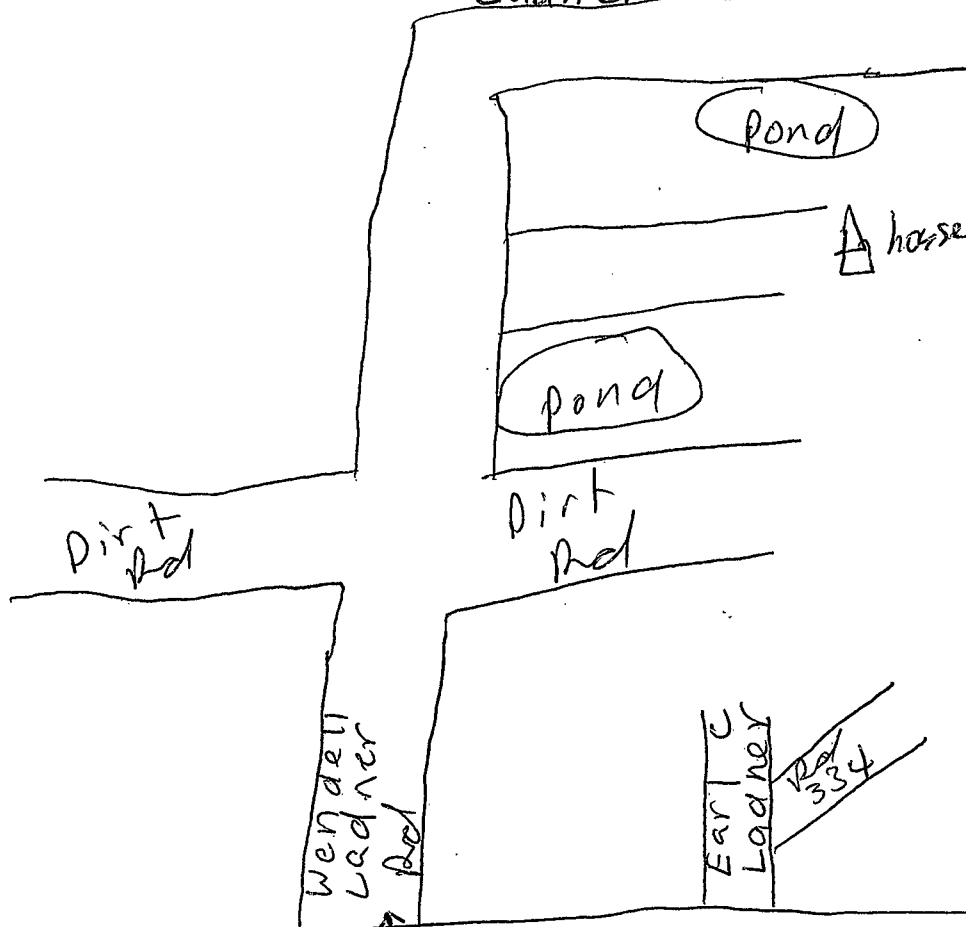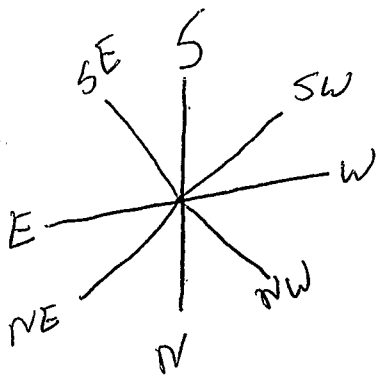

RECEIVED  
JAN 23 2017  
BY OLWR

Shiloh Church Rd

Car wash

Caesar wecaise Rd

perkiston Chevron

HWY 603

Rd 317

Rd 319

HWY 53