

B 2000

8-29-61

WATER WELL DRILLERS LOG

Date: 8-29, 1961, Driller: J. Bevil County Hancock
 (Name)

(1) Owner of Land: J. C. Ladner
Rt 2, Box 2 (Part of 2)
Persepolis Miss
 (Address)

(2) Location: SW 1/4, SS 1/4, Sec. 19 T19 R14
9 miles East of Cesar
 (distance) (direction) (Nearest Town)

(3) Topography: (Hilly) (Flat) (Level)

(4) Purpose of Well: Home
 (Domestic Irrigation, Municipal, Industrial, Other)

Description & Color of Materials Sand, Clay, Red Clay, Shell, etc.	Thick- ness Feet	Depth Feet
<u>Red clay + sand</u>	<u>60</u>	<u>60</u>
<u>white sand</u>	<u>40</u>	<u>100</u>
<u>Blue mud hard</u>	<u>150</u>	<u>250</u>
<u>Fine sand</u>	<u>40</u>	<u>290</u>
<u>strata</u>	<u>81</u>	<u>371</u>
<u>Total Depth</u>		<u>371</u>

Information upon completion of well:

(1) Diameter 2" x 1 1/4" inches.

(2) Total Depth 371 feet.

(3) Water Level 68 feet below top of ground.

(4) Cased to _____, Size _____


(5) Screen: Size 1 1/4", Length 15 ft

(6) Were any formations sealed against pollution?
Backfilled white sand
 yes, _____ no.

If YES depth of formation _____

Why _____

Drillers Remarks: _____

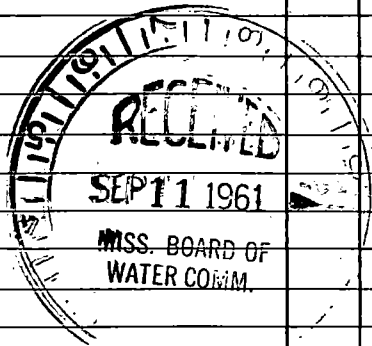

(Use Back Side)

Well No.

