

B 2001

3-31-62

WATER WELL DRILLERS LOG

Date: 3-31, 19 62 Driller: Quick & Grace County P. R.

(Name)

(1) Owner of Land Lazy J Ranch

(Name)

Neaise Crossing

(Address)

(2) Location: 1/4, 1/4, Sec. T R

Neaise Crossing

(distance) miles (direction) of (Nearest Town)

(3) Topography:

(Hilly) (Flat) (Level)

(4) Purpose of Well: Domestic

(Domestic Irrigation Municipal, Industrial, Other)

Description & Color of Materials Sand, Clay, Red Clay, Shell, etc.

Thick-ness Feet

Depth Feet

red clay	0	45
red sand	45	95
blue clay	95	190
fine gray sand	190	220
blue clay	220	245
gray sand	245	312

Information upon completion of well:

- (1) Diameter 2" inches.
- (2) Total Depth 312 feet.
- (3) Water Level 81' feet below top of ground.
- (4) Cased to \_\_\_\_\_, Size \_\_\_\_\_.
- (5) Screen: Size 2", Length 5'.
- (6) Were any formations sealed against pollution?


yes, X no.

If YES depth of formation \_\_\_\_\_

Why \_\_\_\_\_

Drillers Remarks: \_\_\_\_\_

312

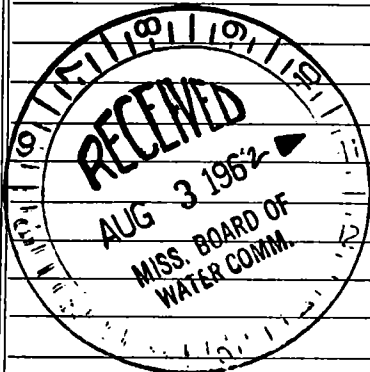

93

Well No.

(Use Back Side)

Handwritten text at the top of the page, possibly a title or header.

Handwritten text in the upper middle section.

Handwritten text in the upper right section.

Main body of handwritten text, appearing as a list or series of notes.

Handwritten text enclosed in a hand-drawn oval.

Handwritten text on the right side of the page, possibly a signature or date.