

**MISSISSIPPI  
BOARD OF WATER COMMISSIONERS**  
416 North State Street  
Jackson, Mississippi 39201

**WATER WELL DRILLERS LOG**

Hancock  
B 2009  
9-3-75

Sept 3 1975 S well work Hancock  
date well completed firm name county well located


LANDOWNER: <u>Buck Jordan</u>	description of formations encountered	from	to
<u>RT 2 PERKINSTON</u>			
<u>MISS -</u> (mailing address)	<u>TOP SOIL</u>	<u>0</u>	<u>3</u>
	<u>CLAY</u>	<u>3</u>	<u>38</u>
	<u>SAND</u>	<u>74</u>	<u>83</u>

**WELL LOCATION:**  
sec. 26 T S N R. 14 E 13 S  
18 miles S of POPPIARVILLE  
(distance) (direction) (nearest town)

**WELL PURPOSE:** HOME  
(home, irrigation, municipal, industrial)


- WELL COMPLETION DATA:**
- (1) diameter (inches) 2
  - (2) total depth (feet) 82
  - (3) static water level (feet) 43 below above top of ground.
  - (4) casing 10 72  
(material) (depth)
  - 2 if telescope see back.  
(size)
  - (5) screen 10 72  
(length) (depth to top)
  - 2 30  
(size) (material)
  - (6) pump 1 5  
(HP) (yield gpm)
  - 50  
(type power)
  - (7) electric log NO  
(yes or no)
  - none  
(organization running log)
  - (8) how well bottom plugged BAW-

**DRILLERS REMARKS:**  
None

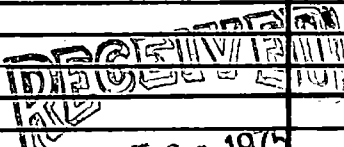  
 OCT 20 1975  
 MISS. BD. OF WATER COMM.

If well telescopes please sketch and show depths.

GROUND LEVEL

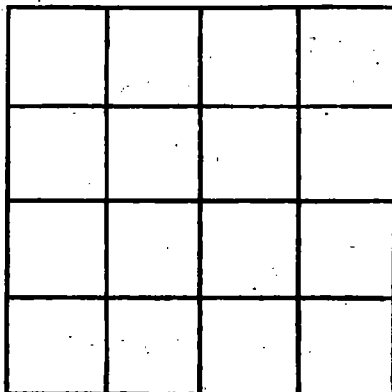

SECTION \_\_\_\_\_

Please indicate well location X.

ADDITIONAL INFORMATION

If more than one screen, show locations of each on sketch.