

HANCOCK
B 2013
4-30-76

MISSISSIPPI
 BOARD OF WATER COMMISSIONERS
 416 North State Street
 Jackson, Mississippi 39201

135

HANCOCK

WATER WELL DRILLERS LOG

4-30 date well completed
 76 Bud Water & Son firm name
 Hancock county well located

LANDOWNER: Clark Smith
Pat. 2
Perkinster Mrs
 (mailing address)

description of formations encountered	from	to
<u>white shale</u>	<u>0</u>	<u>135</u>
<u>white sand</u>	<u>135</u>	<u>165</u>
<u>blue shale</u>	<u>165</u>	<u>250</u>
<u>gray sand</u>	<u>250</u>	<u>285</u>

WELL LOCATION:
 sec 20 T 5 N R 14 E
18 miles East of Purple
 (distance) (direction) (nearest town)

WELL PURPOSE: Home
 (home, irrigation, municipal, industrial)

- WELL COMPLETION DATA:
- (1) diameter (inches) 2 in
 - (2) total depth (feet) 285
 - (3) static water level (feet) 80 below top of ground
 - (4) casing PVC
 (material) (depth)
 - _____ if telescope see back.
 (size)
 - (5) screen 2 x 10 275
 (length) (depth to top)
10 PVC
 (size) (material)
 - (6) pump _____ (HP) _____ (yield gpm)
Electric
 (type power)
 - (7) electric log no
 (yes or no)

(organization running log)
 (8) how well bottom plugged Sand Shank


DRILLERS REMARKS:

RECEIVED

SEP - 1 1976

If well telescopes please sketch and show depths.

GROUND LEVEL

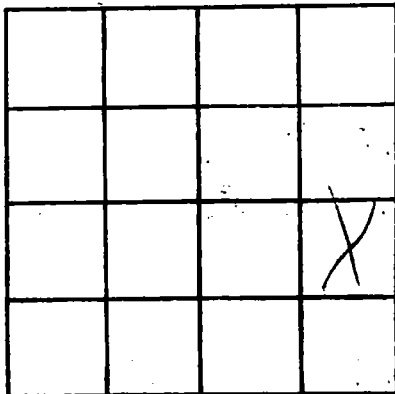

SECTION _____

Please indicate well location X.

ADDITIONAL INFORMATION

If more than one screen, show locations of each on sketch.