

HANCOCK

MISSISSIPPI
BOARD OF WATER COMMISSIONERS
416 North State Street
Jackson, Mississippi 39201

HANCOCK

135

WATER WELL DRILLERS LOG

~~Paul River~~
B 2016
8/9/76

1976 Bud Tinton & Son

Paul River

8-9
date well completed

firm name

county well located

LANDOWNER:

Ricky Paige
Rt. 2, Lubbock, Mo.

description of formations
encountered

from to

<u>Red shale</u>	<u>0</u>	<u>12</u>
<u>Red sand</u>	<u>12</u>	<u>106</u>
<u>White shale</u>	<u>106</u>	<u>200</u>
<u>Gray sand</u>	<u>200</u>	<u>255</u>

(mailing address)

WELL LOCATION:

sec. 28 T 5 N R. 14 E
19 miles East of Wright
(distance) (direction) (nearest town)

WELL PURPOSE:

(home, irrigation, municipal, industrial)

WELL COMPLETION DATA:

- (1) diameter (inches) 2 in
- (2) total depth (feet) 255
- (3) static water level (feet) _____ below above top of ground.
- (4) casing PVC 245
(material) (depth)
- _____ if telescope see back.
(size)
- (5) screen 2 x 10 245
(length) (depth to top)
- _____ (size) _____ (material)
- (6) pump _____ (HP) _____ (yield gpm)
electric
(type power)
- (7) electric log NO
(yes or no)

(organization running log)


(8) how well bottom plugged
hard shale

DRILLERS REMARKS:

RECEIVED
SEP 2 1976

If well telescopes please sketch and show depths.

GROUND LEVEL

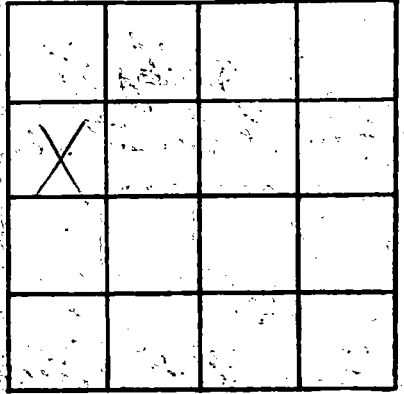

SECTION _____

Please indicate well location X.

ADDITIONAL INFORMATION

If more than one screen, show locations of each on sketch.