

**HANCOCK**  
**B 207**  
**10/25/76**

**MISSISSIPPI**  
**BOARD OF WATER COMMISSIONERS**  
 416 North State Street  
 Jackson, Mississippi 39201

**WATER WELL DRILLERS LOG**

10-25 1976 J. Pouncey water wells Hancock  
 date well completed firm name county well located

LANDOWNER: Mrs. ORA Lee  
TARRISON  
Rt. 2 Pennington -  
MS. Box 194  
 (mailing address)

WELL LOCATION:  
 sec 13 T 5 N R. 14 E  
30 miles SSW of Poplarville  
 (distance) (direction) (nearest town)

WELL PURPOSE: Home  
 (home, irrigation, municipal, industrial)

- WELL COMPLETION DATA:
- (1) diameter (inches) 2
  - (2) total depth (feet) 224
  - (3) static water level (feet) 84 below top of ground.
  - (4) casing PVC 40 (material) 114 (depth)
  - 2 (size) If telescope see back.
  - (5) screen 10 (length) 114 (depth to top)
  - 2 (size) PVC slot (material)
  - (6) pump 1HP (HP) 8 (yield gpm)
  - AC-220V (type power)
  - (7) electric log            (yes or no)
  - (organization running log)
  - (8) how well bottom plugged seal

| description of formations encountered | from to |     |
|---------------------------------------|---------|-----|
|                                       |         |     |
| Clay                                  | 0       | 10  |
| sd                                    | 10      | 174 |
| Clay Iron Rock                        | 12      | 34  |
| Blaukhat                              | 34      | 170 |
| sd very good.                         | 170     | 224 |


good well  
Pump  
fill

DRILLERS REMARKS: Very good  
Deep well sd.  
log - pu

**RECEIVED**  
 FEB 18 1977

If well telescopes please sketch and show depths.

GROUND LEVEL

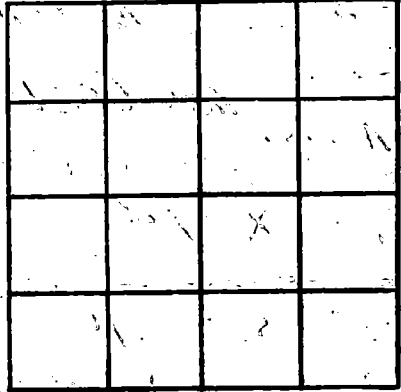

SECTION \_\_\_\_\_

Please indicate well location X.

ADDITIONAL INFORMATION

If more than one screen, show locations of each on sketch.