

HANCOCK
B 2020
3-24-77

MISSISSIPPI
 BOARD OF WATER COMMISSIONERS
 416 North State Street
 Jackson, Mississippi 39201

WATER WELL DRILLERS LOG

3-24 date well completed 1977 ~~Lumpkin Well Co.~~ Hancock county well located
 Stockstill Bros. firm name

LANDOWNER:
 Mr. Miles Biggs
 N.O. La. 70114
 (mailing address)

WELL LOCATION:
 sec. 10 T. N. R. E
 4 5 1/2 East 1/4 W
 (distance) miles (direction) of Decatur (nearest town)

WELL PURPOSE: Home
 (home, irrigation, municipal, industrial)

- WELL COMPLETION DATA:
- (1) diameter (inches) 2"
 - (2) total depth (feet) 740'
 - (3) static water level (feet) 12' below top of ground
 - (4) casing PVC, 730' (material) (depth)
 2" (size) If telescope see back.
 - (5) screen 10', 730' (length) (depth to top)
 2", PVC (size) (material)
 - (6) pump 1/2 (HP) 18 GPM (yield gpm)
 Electric (type power)
 - (7) electric log No (yes or no)
 - (8) how well bottom plugged Sand Shark

description of formations encountered	depth	
	from	to
Clay	0	30
Sand	30	80
Clay	80	95
Sand	95	140
Clay	140	590
Sand	590	740


DRILLERS REMARKS:

RECEIVED
 JUN 17 1977

MISS. BD. OF WATER COMMISSIONERS

If well telescopes please sketch and show depths.

GROUND LEVEL

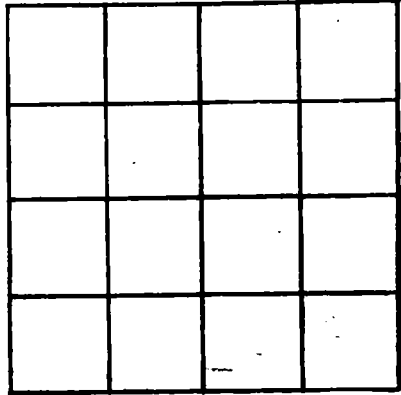

SECTION _____

Please indicate well location X.

ADDITIONAL INFORMATION

If more than one screen,
show locations of each on sketch.