

HANCOCK

B 2672

9-22-78

MISSISSIPPI BOARD OF WATER COMMISSIONERS  
416 North State Street  
Jackson, Mississippi 39201

WATER WELL DRILLERS LOG

9-22-78  
date well completed

19 78 Ward Well Dlg.  
firm name

Hancock  
county well located

LANDOWNER:

E. Shaw

Rt. 4, Box 276  
Poplarville, Miss.  
(mailing address)

description of formations encountered

from to

Clay	0	20
Sandy Clay	20	41
Sd - Mac Donald	41	96
Clay	96	125
fine sd	125	197
Clay	197	205
Coarse sd	205	250

WELL LOCATION:

sec. 9 T. 5 N R. 14 E  
30 miles N of Waveland  
(distance) (direction) (nearest town)

WELL PURPOSE:

Home  
(home, irrigation, municipal, industrial)

WELL COMPLETION DATA:

- (1) diameter (inches) 2"
- (2) total depth (feet) 250
- (3) static water level (feet) 105 <sup>below</sup> above top of ground.
- (4) casing PVC, 240 (material) (depth)  
if telescope see back.  
(size)
- (5) screen 10' (length) (depth to top)  
2" PVC (size) (material)
- (6) pump 1/2 HP (HP) (yield gpm)  
(type power)
- (7) electric log no (yes or no)  
N/A (organization running log)
- (8) how well bottom plugged BWW

RECEIVED


OCT 30 1978

DRILLERS REMARKS:

MISS. BD. OF WATER COMMISSIONERS

If well telescopes please sketch and show depths.

GROUND LEVEL

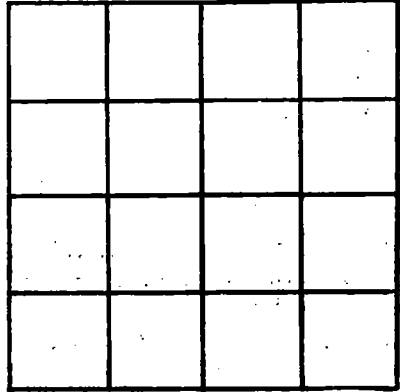

SECTION 9

Please indicate well location X.

ADDITIONAL INFORMATION

If more than one screen, show locations of each on sketch.