

HANCOCK

B

9-30-78

MISSISSIPPI BOARD OF WATER COMMISSIONERS 416 North State Street Jackson, Mississippi 39201

WATER WELL DRILLERS LOG

9-30

date well completed

1978 S. S. Swell Works

firm name

Hancock

county well located

LANDOWNER:

Danny Spiers

description of formations encountered

from

to

Rt-1 Rosechristine

top soil

0 2

Miss

Clay

2 20

(mailing address)

Sand

20 60

WELL LOCATION:

sec 25 T 5 N R 14 E

Clay

60 290

Sand

290 516

1 miles S of #541.913 (nearest town)

WELL PURPOSE:

Home

(home, irrigation, municipal, industrial)

WELL COMPLETION DATA:

- (1) diameter (inches) 2
(2) total depth (feet) 316
(3) static water level (feet) 150 below above top of ground
(4) casing PVC-306 (material) (depth)
(5) screen 10 306 (length) (depth to top)
(6) pump 2 PVC (size) (material)
(7) electric log NO (yes or no)

RECEIVED

OCT 23 1978

(8) how well bottom plugged B.W.


DRILLERS REMARKS:

MISS. Bd. OF WATER COMM

None

If well telescopes please sketch and show depths.

GROUND LEVEL

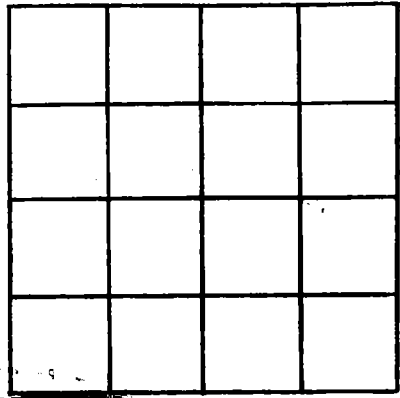

SECTION \_\_\_\_\_

Please indicate well location X.

ADDITIONAL INFORMATION

If more than one screen, show locations of each on sketch.