

HANCOCK  
 B *9/28/75*  
 12-26-78

MISSISSIPPI  
 BOARD OF WATER COMMISSIONERS  
 416 North State Street  
 Jackson, Mississippi 39201

WATER WELL DRILLERS LOG

*Dec. 26* 19 *78* *Duncan Well Drilling* *Hancock*  
 date well completed firm name county well located

LANDOWNER: <i>Elmer Page</i>	description of formations encountered	from	to
<i>Rt. 2 Box 278</i> <i>Poplarville, Ms.</i> (mailing address)			
	<i>Clay</i>	<i>0</i>	<i>25</i>
	<i>sand</i>	<i>25</i>	<i>80</i>

WELL LOCATION:  
 sec. *9* T *S* N R *14* E  
*3* miles *N.E.* of *Decise*  
 (distance) (direction) (nearest town)

WELL PURPOSE: *Home*  
 (home, irrigation, municipal, industrial)

- WELL COMPLETION DATA:
- (1) diameter (inches) *2'*
  - (2) total depth (feet) *80'*
  - (3) static water level (feet) *22'* <sup>below</sup> <sub>above</sub> top of ground.
  - (4) casing *PVC* *70*  
 (material) (depth)
  - if telescope see back.  
 (size)
  - (5) screen *10'* *70'*  
 (length) (depth to top)
  - 2'* *PVC*  
 (size) (material)
  - (6) pump *—* *—*  
 (HP) (yield gpm)
  - (type power)
  - (7) electric log *—*  
 (yes or no)
  - (organization running log)
  - (8) how well bottom plugged *Sand*  
*Mark*

DRILLERS REMARKS:  
*Owner installed*  
*his own pump*


RECEIVED

JAN 10 1978

MISS. BD. OF WATER COMMISSIONERS

If well telescopes please sketch and show depths.

GROUND LEVEL

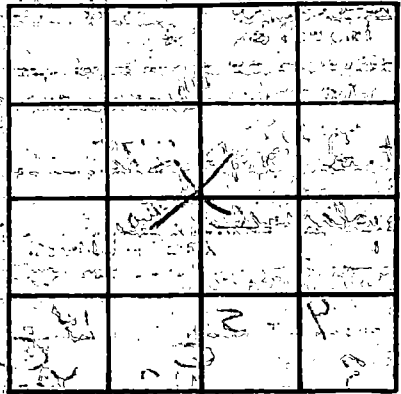

SECTION 9

Please indicate well location X.

ADDITIONAL INFORMATION

If more than one screen, show locations of each on sketch.